

# East Hants Servicing Capacity Study

Technical Memorandum #3: Shubenacadie Water Treatment Plant Assessment Final

# Prepared for: Municipality of East Hants

# Grva

This Technical Memorandum is protected by copyright and was prepared by R.V. Anderson Associates Limited for the account of the Municipality of East Hants. It shall not be copied without permission. The material in it reflects our best judgment in light of the information available to R.V. Anderson Associates Limited at the time of preparation. Any use which a third party makes of this Technical Memorandum, or any reliance on or decisions to be made based on it, are the responsibility of such third parties. R.V. Anderson Associates Limited accepts no responsibility for damages, if any, suffered by any third party as a result of decisions made or actions based on this Technical Memorandum.

RVA 226421 March 15, 2023



R.V. Anderson Associates Limited 2001 Sheppard Avenue East Suite 300 Toronto Ontario M2J 4Z8 Canada Tel 416 497 8600 Fax 855 833 4022 www.rvanderson.com

## RVA 226421

March 15, 2023

Municipality of East Hants Municipal Office Lloyd E. Matheson Centre 15 Commerce Court Elmsdale, NS B2S 3K5

# Attention: Derek Normanton, P.Eng.

Dear Mr. Normanton:

# <u>Re:</u> Shubenacadie Water Treatment Plant Assessment – Technical Memorandum <u>#3– Final</u>

Please find enclosed Shubenacadie Water Treatment Plant Assessment Technical Memorandum #3 – Final.

This Technical Memorandum is with regard to the capacity assessment for the Shubenacadie Water Treatment Plant.

Please contact the undersigned if you have any questions.

## **R.V. ANDERSON ASSOCIATES LIMITED**

Yours very truly,

Jason Angel, M.Sc., P.Eng., PMP

Senior Project Manager

Encls.

R:\2022\226421 - East Hants-Servicing Capacity Study\08 Design\09 Reports\TM#3 -Shubenacadie WTP\226421-20230315-East Hants - Shubenacadie WTP-TM#3.docx

# East Hants Servicing Capacity Study

# Technical Memorandum #3: Shubenacadie Water Treatment Plant Assessment

# TABLE OF CONTENTS

1.0	INTR	RODUCTION 1				
	1.1 1.2	Objective Background				
2.0	ΡΟΡΙ	JLATION ESTIMATES AND PLANT CAPACITY	3			
	2.1	Process Equipment and Capacity	3			
	2.2 2.3 2.4	2.1.1Wells and Well Pumps2.1.2Sand Media Filters2.1.3Water Softeners2.1.4Carbon Filter2.1.5Chlorine Disinfection System2.1.6Corrosion Control System2.1.7Future UV System2.1.8Backwash Storage2.1.9Treatment RequirementsPopulation EstimateHistorical Water Demands and Maximum Day FactorPer Capita Water Usage	44566666780			
	2.5	Plant Capacity1	U			
3.0	SITE	ASSESSMENT1	1			
	3.1 3.2	Process1 Mechanical, Electrical, Communication and General Building1				
4.0	ASSE	T COSTS AND TIMELINES FOR REPLACEMENT1	3			
5.0	CON	CLUSIONS14	4			
	5.1	Recommendations14	4			
6.0	REFE	RENCES	5			

# LIST OF TABLES

- Table 2.1 Population Estimates Provided by Municipality of East Hants
- Table 2.2 Average Daily Flow and Maximum Daily Flow from 2017 2021
- Table 2.3 Historical Water Consumption Data in Shubenacadie between 2017 and 2021
- Table 4.1 Approximate Asset Costs and Timelines for Replacement

# LIST OF FIGURES

- Figure 2.1 Sand Filter Name Plates
- Figure 2.2 Water Softener Name Plates

Figure 2.3 – GAC Filter Name Plate

- Figure 2.4 Historical Water Use in Shubenacadie
- Figure 2.5 Chlorine Contact Pipe

# APPENDICES

- APPENDIX A Record Drawings by Horner Associates Limited
- APPENDIX B Supporting Supplier Information

# 1.0 INTRODUCTION

The Shubenacadie Water Treatment Plant is situated at 2882 Highway 2 Shubenacadie, Nova Scotia, and services the community of Shubenacadie as part of the water distribution system of the Municipality of East Hants. It was originally constructed in 2011 to replace an existing water treatment system that has since been decommissioned.

The Municipality of East Hants is evaluating the capacity of the Shubenacadie Water Treatment Plant to meet the 2047 projected pumping demand based on the projected population to 2047. Additionally, the Municipality of East Hants is evaluating the life cycle and projected replacement costs in the immediate term (0-5 years) and the future (25 years).

# 1.1 Objective

R.V. Anderson Associates Limited (RVA) was retained by the Municipality of East Hants to perform an assessment of the Shubenacadie Water Treatment Plant to determine the plant's ability to meet 25-year water demands.

The objectives of this assessment are to:

- Calculate the plant's current capacity.
- Review the 25-year anticipated population.
- Calculate the 25-year anticipated water demand for the Shubenacadie Water Treatment Plant
- Provide estimated asset costs and timelines for replacement in the immediate term (0-5 years) and after 25 years
- Perform a site review assessment of the general condition of the water treatment plant and associated infrastructure
- Provide recommendations for any upgrades required to meet the 25-year water demands

This report provides population and water demand estimates to 2047 to assist the Municipality of East Hants in determining the ability of the Shubenacadie Water Treatment Plant to meet 25-year demands.

# 1.2 Background

The Shubenacadie Water Treatment Plant was constructed between 2009 and 2011 at a cost of \$2,448,140.00 (Infrastructure Canada, 2016). Adjusted for inflation using the Stats Canada Building Construction Price Index (BCPI, Non-Residential, Halifax) this would roughly equate to a present-day cost of about \$3.6 M. The record drawings prepared by Horner Associates Limited are provided for reference in **Appendix A**. The plant treatment train includes the following sequence:

- 1. Water is pumped from one or two well pumps (PW-2 and PW-2019). The following withdrawal rates apply to the wells.
  - a. The 30-day maximum withdrawal rate is 740 m<sup>3</sup>/day
  - b. The 3-day maximum withdrawal rate is 1000 m<sup>3</sup>/day.
  - c. The monthly withdrawal limit is 22,200 m<sup>3</sup>
  - d. The annual withdrawal limit is 270,100 m<sup>3</sup>
- 2. Water flows through one or two parallel sand media filters. Each filter has a capacity of 12.6 L/s. There is space available for an additional sand filter in the future.
- 3. Water flows through one of two ion exchange water softeners. Each softener has a capacity of 9.8 L/s, with the ability to allow an untreated bypass. In addition to the softeners, there is a brine tank and brine pump. There is space in the plant for a future ion exchange water softener.
- 4. Water flows through a granular activated carbon (GAC) filter for aesthetic polishing. The filter has a capacity of 12.6 L/s and there is only 1 filter. However, there is space for 1 or 2 additional GAC filters in the future.
- 5. Water is injected with chlorine gas and proceeds through the chlorine contact piping for primary and secondary disinfection.

The system also has a phosphate-based corrosion control system that consists of a 264 L storage tank and dosing pumps.

There is also a backwash equalization tank for backwash water from the sand filters, water softeners, and GAC filter. Duplex pumps discharge the backwash water to a nearby manhole and sanitary sewer.

Additionally, the original facility design considered the addition of UV if alternative disinfection methods were found to be required. This includes both an available footprint in the facility and allocated electrical capacity.

The plant operation is primarily driven by the standpipe water levels. The standpipe high and low limits cause the system to start and stop.

# 2.0 POPULATION ESTIMATES AND PLANT CAPACITY

# 2.1 **Process Equipment and Capacity**

The following sections describe the capacity of each process step involved in the Shubenacadie Water Treatment Plant. Hydrogeological studies, investigations and assessments have been completed by East Hants regarding the Shubenacadie groundwater supply. The assessments to date have had NON-GUDI determinations of their groundwater supply. This includes the assessments completed on the original supply wells during construction and initial operation of the facility, and most recently on the new PW2019 well (Earth-Water Concepts Inc., 2022). East Hants should have the groundwater supply GUDI assessment documentation filed for record keeping purposes and ease of future referencing.

Recent annual reporting has not indicated any long-term adverse parameters in treated water requiring treatment rectification. The sole exception has slight and short-term increased sodium, turbidity, colour and manganese concentrations; however, these were noted as being rectifiable via operational adjustments such as flushing, sampling procedures and laboratory analysis techniques.

Recent raw sampling programs have identified certain parameters such as turbidity, iron, manganese, aluminium, and radionuclides above Maximum Acceptable Concentration (MAC) or Aesthetic Objective Limits (AO) in the raw water; however, finished water remains in compliance. These exceedances are noted to be primarily linked to a well that is no longer in service.

Based on these requirements the overall treatment process is primarily driven by disinfection requirements and the treatment train is primarily for aesthetic parameters.

Should the concentrations of the aforementioned raw water parameters increase to MAC or AO levels, then the requirements of the treatment process would become more stringent to ensure their reduction or removal.

# 2.1.1 Wells and Well Pumps

The Shubenacadie Water Treatment Plant currently runs off two groundwater wells, PW-2 (installed in 2007) and PW-2019 (installed in 2019). When the plant was first commissioned, it was supplied by wells PW-1 and PW-2; however, PW-1 has since been decommissioned because the internal components of the well failed.

There are currently two (2) ITT Goulds Model 160L15 well pumps, as well as a shelf spare. Each has a rated capacity of 9.5 L/s @ 76 m head (150 USGPM @ 250 ft head). The typical output of the plant is 7.6 L/s @ 58 m head (100 IGPM @ 82 psi)

# 2.1.2 Sand Media Filters

After water is pumped to the WTP by the well pumps, water flows through one of the two sand media filters, each of which has a capacity of 12.6 L/s (see Figure 2.1 below). The original plant operation manual prepared by Horner and Associates indicates the sand media filters are primarily to protect the downstream ion exchange water softeners by removing solids. The sand filters help to remove particulates, which aids in improving the water quality. However, the system requirements for treatment do not necessitate the sand media filters at this time. Therefore, the sand media filters are not essential; however, they do protect the ion exchange/water softener units.



Figure 2.1 – Sand Filter Name Plates

# 2.1.3 Water Softeners

Following sand filtration, a portion of the water (approximately 60%) proceeds to one of two water softeners, and a portion of the water (approximately 40% in the original design operations manual) bypasses the softeners to reduce the hardness from approximately 261 mg/L to approximately 100 mg/L. The operator has manual control of the bypass and must adjust the bypass to bring the water hardness towards the 100 mg/L target. Each softener has a capacity of 9.8 L/s. In addition to removing hardness, the softeners remove iron and manganese to improve the aesthetic quality of the water.



Figure 2.2 – Water Softener Name Plates

## 2.1.4 **Carbon Filter**

After softening, the blended water flows through the granular activated carbon (GAC) filter as a polishing step. The GAC filter has a capacity of 12.6 L/s and removes hydrogen sulfide (H<sub>2</sub>S) from the water to improve the water aesthetics.



Figure 2.3 – GAC Filter Name Plate

**FINAL** 

Page 5

# 2.1.5 Chlorine Disinfection System

Finally, after GAC filtration, water is disinfected with chlorine gas. The disinfection system consists of two (2) chlorine gas cylinders (one duty, one standby, with a scale and switchover system, each cylinder with a capacity of 68 kg), as well as serpentine piping to provide additional contact time for disinfection. This chlorine injection point is for both primary and secondary disinfection. The drawings indicate that there is space for the storage of ten (10) chlorine cylinders.

# 2.1.6 Corrosion Control System

In 2013, a Carus phosphate dosing system was installed in the plant. It consists of a 264 L tank and a chemical injection system.

# 2.1.7 Future UV System

The record drawings by Horner Associates Limited (**Appendix A**) show space for a future UV system within the plant both with respect to plant footprint and spare electrical capacity.

# 2.1.8 Backwash Storage

The Municipality of East Hants has noted operational challenges with backwashing, as the well production is below the required backwash flowrate. Well water is used to backwash the sand filters, water softeners, and GAC filter. A backwash supply storage tank and pump system could be added to increase the volume and flows of water available for backwashing. Options include adding a tank inside the existing water treatment plant building or buried outside the building. A minimum volume of supply of 8,000 L is recommended; however, a greater volume is likely required to ensure that the entire 8,000 L is available as a functional volume. The system would require duty and standby pumps, as well as modifications to the plant's control and electrical systems. Changes to the piping would also be required to accommodate this new backwash approach. A quotation from Napier Reid for an internal backwash tank has been appended. Additional quotes were also obtained for an external tank option; however, many of the elements from the Napier Reid quotation would also be required for the external tank option. Additional design is required in the future to facilitate a new backwash system. During the future design, there may be potential to find a more economical or value engineered option for this backwash system.

# 2.1.9 Treatment Requirements

Overall, the current treatment train is adequate to produce potable water in accordance with Nova Scotia Environment requirements. Additionally, the treatment system has the

flexibility to add treatment train redundancy via space for additional media vessels or alternative disinfection methods such as UV.

# 2.2 **Population Estimate**

The Municipality of East Hants provided RVA with low, mid, and high-range population estimates from 2022 - 2047 for this assessment. RVA was instructed to use the mid-range population projection for this study. Based on this mid-range projection, the estimated population in 2047 is 1033. See Table 2.1 below. Additionally, to calculate the per capita water usage, RVA used Census data and linear interpolation to determine the approximate population between 2016 – 2021 using the Municipality's data from 2022 – 2047. The Municipality of East Hants provided the following supporting information with their population projections:

"Population estimates for Shubenacadie are based on 2.5 people/dwelling and the potential development as described in the development table. Very little development has been approved in Shubenacadie over the last number of years due to a lack of service capacity. The current construction of a new sewer treatment plant is expected to trigger some increase in development in the area. Low, medium and high development scenarios have been broken out below based on development estimates."

"\*Disclaimer: development and population values are estimates generated by Municipal staff based on a combination factors including, but not limited to: known/proposed future development, development trends, zoning, land vacancy, and the 2021 Census data for average number of people per dwelling in the area. Low, mid, and high estimates for development and population have been calculated to cover a range of possible scenarios. These numbers are to be used as a guide only; the Municipality does not guarantee the accuracy of any data provided herein."

Year	Population
2016*	735
2021**	775
2022	785
2027	850
2032	920
2037	958
2042	995
2047	1033
Statistics Canada, 2016 Census	

## Table 2.1 – Population Estimates Provided by Municipality of East Hants

\*\*Interpolated between Census and provided 2022 population


## 2.3 **Historical Water Demands and Maximum Day Factor**

The Municipality of East Hants monitors daily raw water flow to the Shubenacadie Water Treatment Plant, as well as total treated flow in L/day. However, the total treated flow was sometimes greater than the raw water flow. Therefore, whichever value was higher between the treated flow and the raw water flow was used in the calculation of maximum demand flow, average demand flow, lowest daily flow, etc.

Historical maximum day demands were determined by looking for the highest daily demand recorded in the Municipality of East Hants's data. Maximum day factors were calculated by dividing the maximum day demand of a certain year divided by the yearly average day demand.

Figure 2.4 presents a summary of key water usage parameters in Shubenacadie between 2017 and 2021. The average day demands in Shubenacadie varied between 244,000 and 327,000 L/d, with an overall average daily demand of 281,000 L/d. The maximum daily demand varied between 480,000 and 625,000 L/d, while the maximum day factor averaged 2.1.

Table 2.2 and Table 2.3 and shows key parameters that can be used to forecast water demands that align with the planned growth of Shubenacadie.

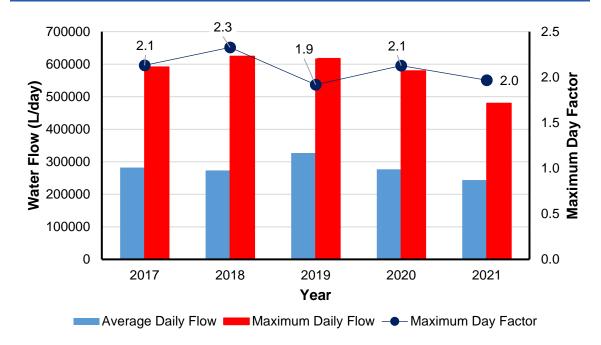

# Figure 2.4 – Historical Water Use in Shubenacadie

# Table 2.2 – Historical Water Consumption Data in Shubenacadie between 2017 and2021

Highest Maximum Day Demand Flow	625,000 L/d
Average Day Demand of All Years	281,000 L/d
Lowest Daily Flow	58,000 L/d

Year	Average Daily Flow (L/d)	Maximum Daily Flow (L/d)
2017	282,000	592,000
2018	273,000	625,000
2019	327,000	618,000
2020	277,000	580,000
2021	244,000	480,000

Table 2.3 – Average Daily Flow and Maximum Daily Flow from 2017 – 2021

The Maximum Day Factor was calculated for 2017 - 2021 and ranged from 1.9 - 2.3. The average value for 2017 - 2021 was 2.1; therefore, a maximum day factor of 2.1 will be used for the plant. Refer to Technical Memorandum #4 regarding factors used for the water modelling exercise, which are tied to the distribution system.

# 2.4 Per Capita Water Usage

The Per Capita Water Usage of the Shubenacadie Water Treatment Plant was calculated using historical water use data, as well as Census data and linear interpolation to determine the approximate population between 2016 – 2021 using the Municipality's data from 2022 – 2047. from 2016 – 2021. Two per capita water usage values were calculated. The Net Per Capita Value is 366 L/Cap/Day, and the Gross Per Capita Value is 384 L/Cap/Day. The Net Per Capita Water Usage Value was calculated using the average flow of treated water in L/day, as well as the population. This value is used for the water model and includes all distribution demands, losses, etc. The Net Per Capita Value is exclusive of the water consumed internally by the water treatment plant processes. The Gross Per Capita Water Usage Value was calculated based on 5% internal water use at the water treatment plant. This value was used to determine the required plant gross capacity, as there were discrepancies between the raw and treated water flow rates, which made it challenging to determine which reading was correct. See Section 3.1 for additional detail regarding the flow meter. Therefore, a 5% internal water use value was utilized, based on standard literature values (MWH's Water Treatment, John C. Crittenden, 2005).

Using the maximum day factor of 2.1, the Gross Per Capita Water Usage Value of 384 L/Cap/Day, and the mid-range population estimates, the anticipated maximum daily flow in 2047 for the Shubenacadie Water Treatment Plant is 9.6 L/s.

# 2.5 Plant Capacity

The current rate-limiting step for the Shubenacadie water treatment plant is the well pumping limits. The maximum is  $1000 \text{ m}^3$ /day averaged over 3 days, which is equivalent to 11.6 L/s. In terms of process equipment, the sand filters have a capacity of 12.6 L/s and are noted to primarily reduce turbidity for the softening units. Although the softeners have a capacity of 9.8 L/s, the water softening is considered optional and therefore, this does not limit the overall capacity of the plant. The softeners were also designed with a 40% total plant flow bypass rate of 40% (2.8 L/s). The GAC system has a capacity of 12.6 L/s as well and is not rate-limiting since it is considered a polishing step.

Finally, based on the CT of the disinfection system, the maximum flow to maintain an adequate chlorine residual of 1 mg/L is 23.8 L/s based on 4-log virus removal, based on NSE Requirements. The pipe parameters used to assume the volume for CT calculations should be more explicitly noted in the Municipality's documentation. The volume calculation should note the parameters of the contact pipe and the location where primary disinfection is fully achieved. Figure 2.5 illustrates that it could be interpreted that only the serpentine pipe loop provides contact time; whereas it appears that the entire discharge pipe to the distribution system is used for CT. However, there are washroom and water

taps within the plant that draw water from the end of the serpentine loop, which does not use the additional distribution pipe used in the CT calculation. This could technically deem the water used within the facility as non-potable, as the serpentine loop has about half the available contact time compared to the serpentine loop + distribution pipe.

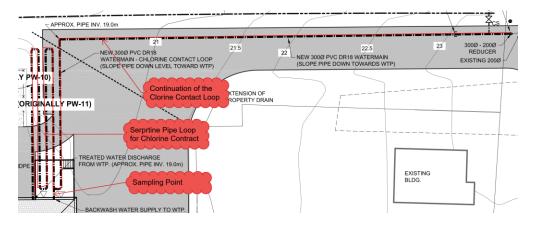


Figure 2.5 – Chlorine Contact Pipe

Since the maximum demand for the servicing area of Shubenacadie is 9.6 L/s in 2047, capacity upgrades to the plant are not required in the immediate term (0-5 years) or the next 25 years. However, it is recommended to plan to drill at least one additional well in the immediate term (0-5 years), since PW-1 failed in recent years. Additionally, to upgrade the plant in the future, at least one (1) additional well will be required, and upgrades to the plant process equipment will be required for flows over 12.6 L/s. In general, due to the arrangement of the system, an expansion would likely entail providing an additional and equivalent tank for the sand media, softeners and GAC media filters that would double the current capacity to 25.2 L/s.

# 3.0 SITE ASSESSMENT

A site assessment of the Shubenacadie Water Treatment Plant was completed on October 12, 2022, to document the existing conditions and compare the data and operations to record information. The findings of the site assessment are summarized in the following sections.

# 3.1 Process

The equipment has been in operation for about ten (10) years and is still in overall good condition. Some slight rusting and minor corrosion can be noted on certain steel or iron piping components.

Recent changes to the facility's raw water supply include a new PW 2019 well and the discontinuation of the PW11 well. This included pump replacement and the provision of a shelf spare pump.

A storage rack for salt bags has also been added to the facility since its original construction.

The filtration media has not been replaced since its original installation in 2011. At present, there have not been any noticeable changes in performance. Filtration media can require ongoing replacement to offset for media lost during backwashing and/or full replacement once performance has worsened. There may be value in implementing additional monitoring of the media performance to allow more quantitative assessments to be made. This can also include metrics to aid when backwashing or regeneration is required.

Filtration metrics may include the following:

- Filter run-times
- Pressure drops
- Filtrate quality
- Backwashing parameters (flow, duration)
- Overall recovery rates (Gross vs. net water production)

Plant operations also noted that there can be occasional challenges with sufficient backwash supply tied to insufficient water supply for backwash flow rates. The cause and potential solution(s) for this would require additional investigation.

On review of the raw and treated water flow data, it appears that there may be a minor discrepancy with the flow meters, as treated flows slightly exceed raw flows. This flow discrepancy makes it difficult to track overall treatment system recovery that can provide a simple process performance tracker on overall plant recovery. The discharge flowmeter also appears to be installed in a vertical position with downward flow and this is a non-ideal arrangement that can impact readings. The flowmeter on the backwash supply should consider programming changes to allow for corrections to the total plant discharge flows.

# 3.2 Mechanical, Electrical, Communication and General Building

A dehumidifier was added to the building in May 2022 due to address mold issues.

The facility has been in operation for about ten (10) years and is still in overall good condition for these components.

- MCC and associate panels within a separate electrical room
- Ceiling lights
- HMI and SCADA communications systems
- Levels sensors and monitors
- Dehumidification System
- Chemical Feed Pumps
- Interior walls, floor and ceiling
- Exterior walls, roof and loading dock

The rooms within the plant lack proper ventilation systems, there is localized rusting on piping at eye wash and in-line valves within process piping. The interior man access doors show signs of rust and deterioration.

# 4.0 ASSET COSTS AND TIMELINES FOR REPLACEMENT

**Table 4.1** below shows approximate asset costs and timelines for replacement for the Shubenacadie Water Treatment Plant. Rows highlighted in red, yellow, and green represent assets identified for replacement in 0-5 years, 6-25 years, and >25 years, respectively. Approximate costs are provided in 2022 values in CAD, excluding tax. Any relevant quotes or supplier information will be included in an appendix. Napier Reid quoted \$1,130,000 for two sand filters and appurtenances, two water softeners and appurtenances, one activated carbon filter and appurtenances, associated PLC, Shop Drawings, O&M Manuals, Field Service, and Inspection. Napier also Reid quoted \$870,000 for the following: One sand filter and appurtenances, one water softener and appurtenances, one activated carbon filter and appurtenances, five (5) various 100 mm butterfly valves, and associated PLC for the aforementioned equipment. The estimates for life span are based on RVA's experience with water systems as well as data from the USEPA for asset life spans for small water systems (2003). Life spans are approximate and may vary depending on the state of the assets and how frequently the assets undergo maintenance and the nature of the maintenance.

Asset	Cost (2022 values in CAD, excluding tax)	Life Span (years)	Year of Installation
Well PW-2	\$110,000	25-35	2007
Well PW-2019	\$110,000	25-35	2019
Well Pump PW-2	\$18,000	10-15	2011
Well Pump PW- 2019	\$18,000	10-15	2019
Sand Filters	\$400,000	15-25	2011
Softening System	\$400,000	15-25	2011
GAC Filter	\$400,000	15-25	2011
Chlorine Treatment System	\$180,000	15	2011
Corrosion Control	\$20,000	15	2013
Future UV System	\$170,000	15	2023*
SCADA System	\$110,000	15	2011
Emergency Power	\$250,000	15	2011
Backwash System	\$280,000	30-60	2023**
Building and property	0%-7% of building replacement value per year***	30 to 90, depending on the asset	2011

# Table 4.1 – Approximate Asset Costs and Timelines for Replacement

\*Note: will be required if water is ever deemed GUDI. Cost assumes 1 duty plus 1 standby unit and a UVT sensor and analyzer

\*\*Recommended to install. Requires additional design. Refer to appended quotes received for an internal tank-based system. Quotes have also been received for an external tank. Many of the items required for the internal tank system would also be required for the external tank system (with the exception of the internal tank and piping costs).

\*\*\*General building and property are difficult to estimate due to the variety of factors involved. The National Research Council Study "Expenditures for the operation and maintenance of buildings" indicated that a range can be used based on the replacement costs of the building that can vary from 0 – 7% per year, with 0.5% per year as a 6-year average. Deferred maintenance costs would accumulate.

# 5.0 CONCLUSIONS

# 5.1 Recommendations

Since the current rate-limiting step for the Shubenacadie Water Treatment Plant is the well pumps, it is recommended to drill an additional well to increase the capacity of the plant in the future. Provision for a second additional well may be considered to provide additional redundancy to the water supply since well PW-1 failed in recent years.

Additional studies and engineering design would be required for an additional well, as well as capital costs for drilling and piping.

Monitoring programs should be implemented to allow media system performance to be tracked to provide a means to confirm changes in performance.

Ongoing maintenance and replacement costs should be tracked to help confirm ongoing expenditures as the facility ages. The USEPA has several good guides and templates to aid with asset management and can allow it to be simply tracked and undertaken by the Municipality. Any quotes/estimates obtained and actual costs once undertaken for maintaining these assets should be logged.

If one of the wells is ever deemed GUDI, or if a future well is GUDI, the addition of the UV system will be required.

Given the failure of PW-1 in recent years, the following are suggested

- Well inspection every 5 years
- Consideration for investigating a new standby well

Additionally, the following investigations are suggested in the immediate term (0-5 years):

- Investigate the cause of the backwash system deficiencies, evaluate options and design an improved backwash supply system, potentially including a backwash supply tank and pumping system
- Evaluate a means to calculate the treated plant outflow more accurately, considering the orientation of the flow meter and the flows associated with backwashing
- Detailed evaluation of treated water quality, and study to evaluate optimization of the treatment train. For example, consideration as to whether adding a location of chlorine application earlier in the treatment train could optimize iron, manganese and H<sub>2</sub>S removal.

Refer to Table 4.1 for upgrades/ replacements recommended based on asset life span in the immediate term (0-5 years) and within the next 6-25 years, as well as their estimated replacement costs.

# 6.0 **REFERENCES**

Earth-Water Concepts Inc., "Shubenacadie PW2019 Step 2 GUDI Hydrogeological Assessment," 2022.

Infrastructure Canada. (2016, January 28). *Infrastructure Canada Projects since 2002 - Nova Scotia*. Available: <u>https://www.infrastructure.gc.ca/investments-2002-investissements/ns-list-eng</u>

J.C. Crittenden, *MWH's Water Treatment: Principles and Design,* 3<sup>rd</sup> ed., MWH's Water Treatment, John C. Crittenden, 2005.

National Research Council Canada, "Expenditures for the Operation and Maintenance of Buildings," F. Steel, 1985.

United States Environmental Protection Agency, "Asset Management: A Handbook for Small Water Systems," USEPA, 2003.

# **APPENDIX A**

**Record Drawings by Horner Associates Limited** 

# **MUNICIPALITY OF EAST HANTS**

# Shubenacadie Water Treatment Plant **July 2010**


WORK OF THIS CONTRACT WAS PERFORMED BY L & R CONSTRUCTION LTD.



# **Record Drawings** November 2011



LOCAT	
	EW BRUNSWICK BRU
	LIST OF DRAWINGS
DWG No.	DRAWING TITLE
101 102 201 202 301 302 303 304 305 306 401 402 403 501 502 503 601 602 603	EXISTING & FINISHED SITE PLAN SITE SERVICES PLAN FOUNDATION PLAN FOUNDATION DETAILS BUILDING ELEVATIONS FLOOR PLAN ROOF PLAN WALL SECTIONS DOOR SCHEDULE, ROOM FINISH SCHEDULE & DETAILS MISCELLANEOUS DETAILS PROCESS SCHEMATIC PROCESS PIPING PLAN & DETAILS PLUMBING & VENTILATION ELECTRICAL SITE PLAN, SPECIFICATIONS & DETAILS LIGHTING & HEATING LAYOUT, LEGEND & PANEL SCHEDULES ELECTRICAL POWER & AUXILIARY SYSTEMS LAYOUT & DETAILS CONTROL DEVICE LOCATION DRAWING CONTROLS CABLE BLOCK DIAGRAM DETAILS
SET	OJECT No. LH0922160 No JE DATE:

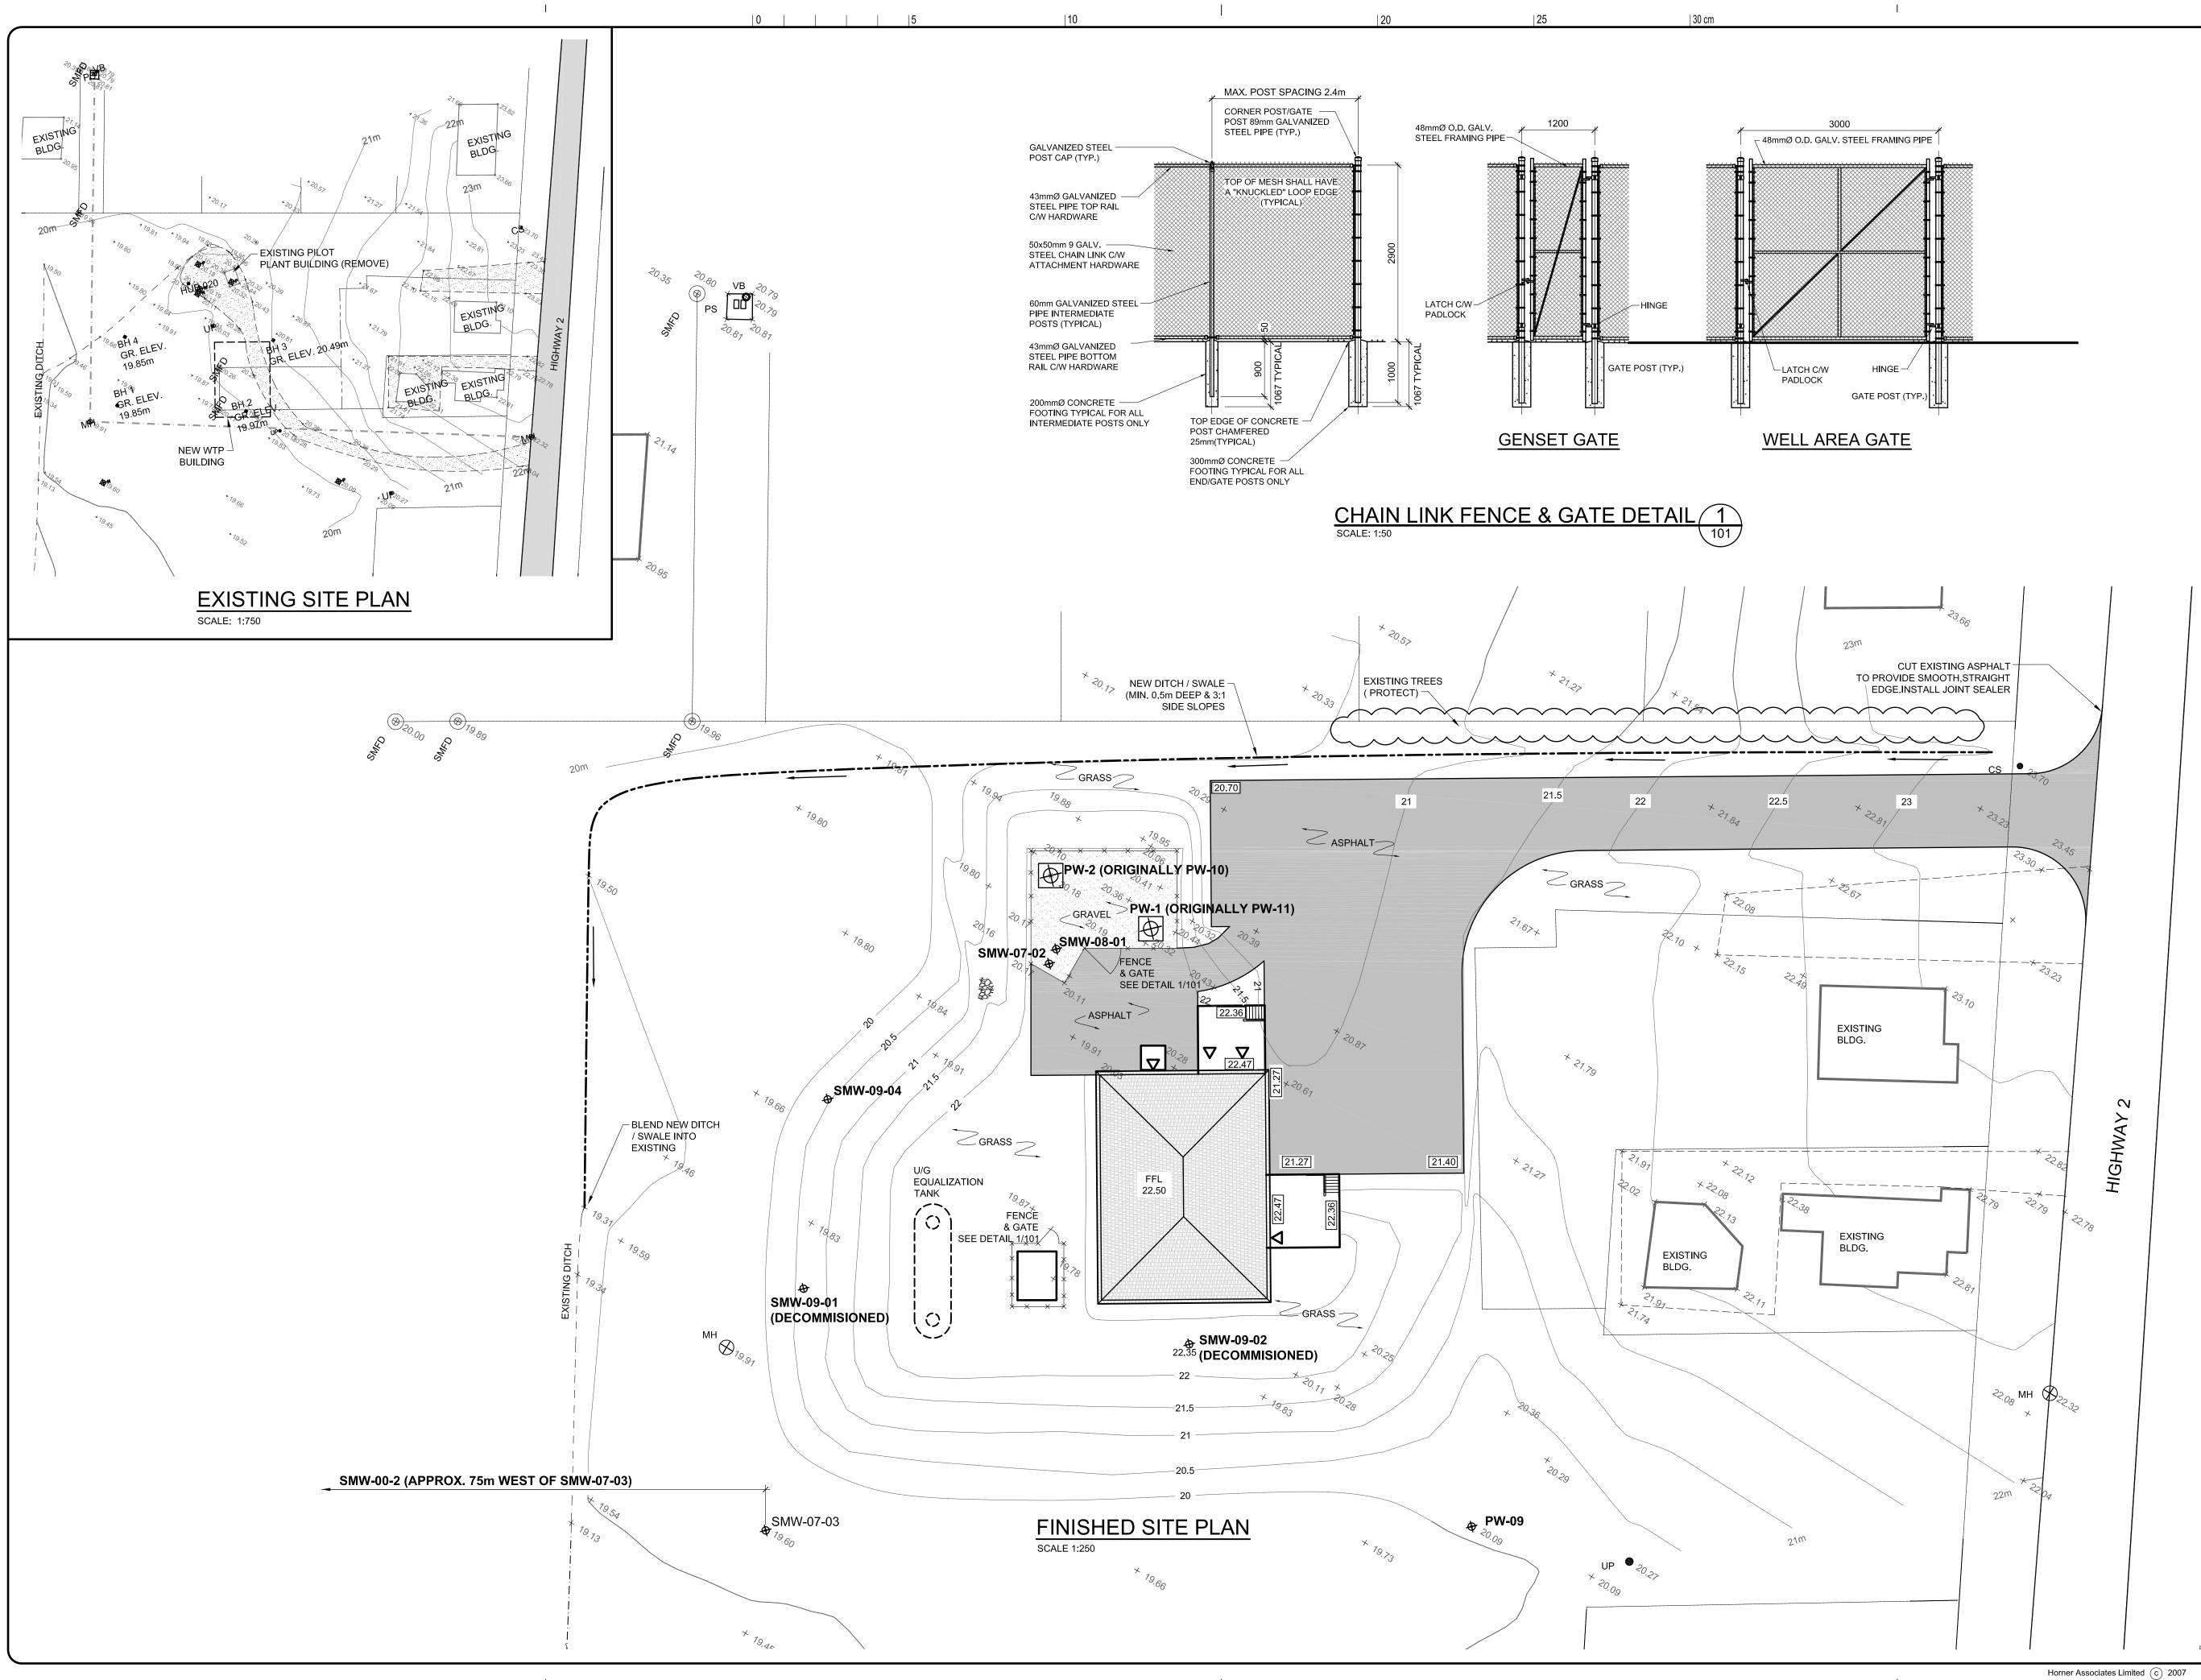



Ι

I

—

No.	Issue			Date				
Not	E0.							
	EMOVE TOPSOIL AND ALLUVI							
R A	O 1.8m DEPTH) IN THE AREA O EMOVE TOPSOIL AND ORGAN REAS OF CONSTRUCTION. PR OF ALL EXCAVATION.	ICS IN	ALL OTH	IER				
2. B	ACKFILL UNDER THE BUILDING							
V	VITH THE STRUCTURAL DRAW EOTECHNICAL REPORT.							
В	ACKFILL PAVED AND GRAVEL ORROW TO 525mm BELOW FIN 00mm OF TYPE II GRAVEL, 150	VISHE	O GRADE	PLUS				
À	AND 75mm OF ASPHALT IN PA\ LL BACKFILL TO 98% STANDA 00mm LIFTS.							
C	ACKFILL OTHER AREAS OF CO	BELOV	V FINISH	ED				
-	RADE PLUS 100mm OF TOPSC END:		JHYDRO	SEED.				
ר ה		LL						
4	PRODUCTION WELL							
1 No.	Record Information Added		GAR Ckd. By	Nov. 2011 Date				
<u> </u>								
Stamp			Ist. North	J				
··· <b>·</b> F								
<b>–</b>	1							
	ORIGINAL DRAWING STAMPED ON							
	02 July 2010 BY G. A. ROSS P. ENG.		wn By:	STAFF				
		Ckd	9. Standarc . By: igned By:	ls				
			g. Design					
Date F		Ckd Brai	. By: nch					
	2-JULY-2010	Mar	ager:	<u>.</u>				
$\overline{)}$	<b>HOH</b>	R	Ν	EF				
	ASSOCI consulting a							
89 Qu Truro,	een Street NS			<u>ad</u>				
Client								
I	Municipality of	Eas	st Ha	ants				
•								
Projec	Project Title Shubenacadie							
Water Treatment Plant Drawing Title Existing & Finished Site Plan								
				Projec	t No. LH0922	160		
				Dwg. No. Rev. No. 1 Scale				
	1:250 This drawing is not to		led					

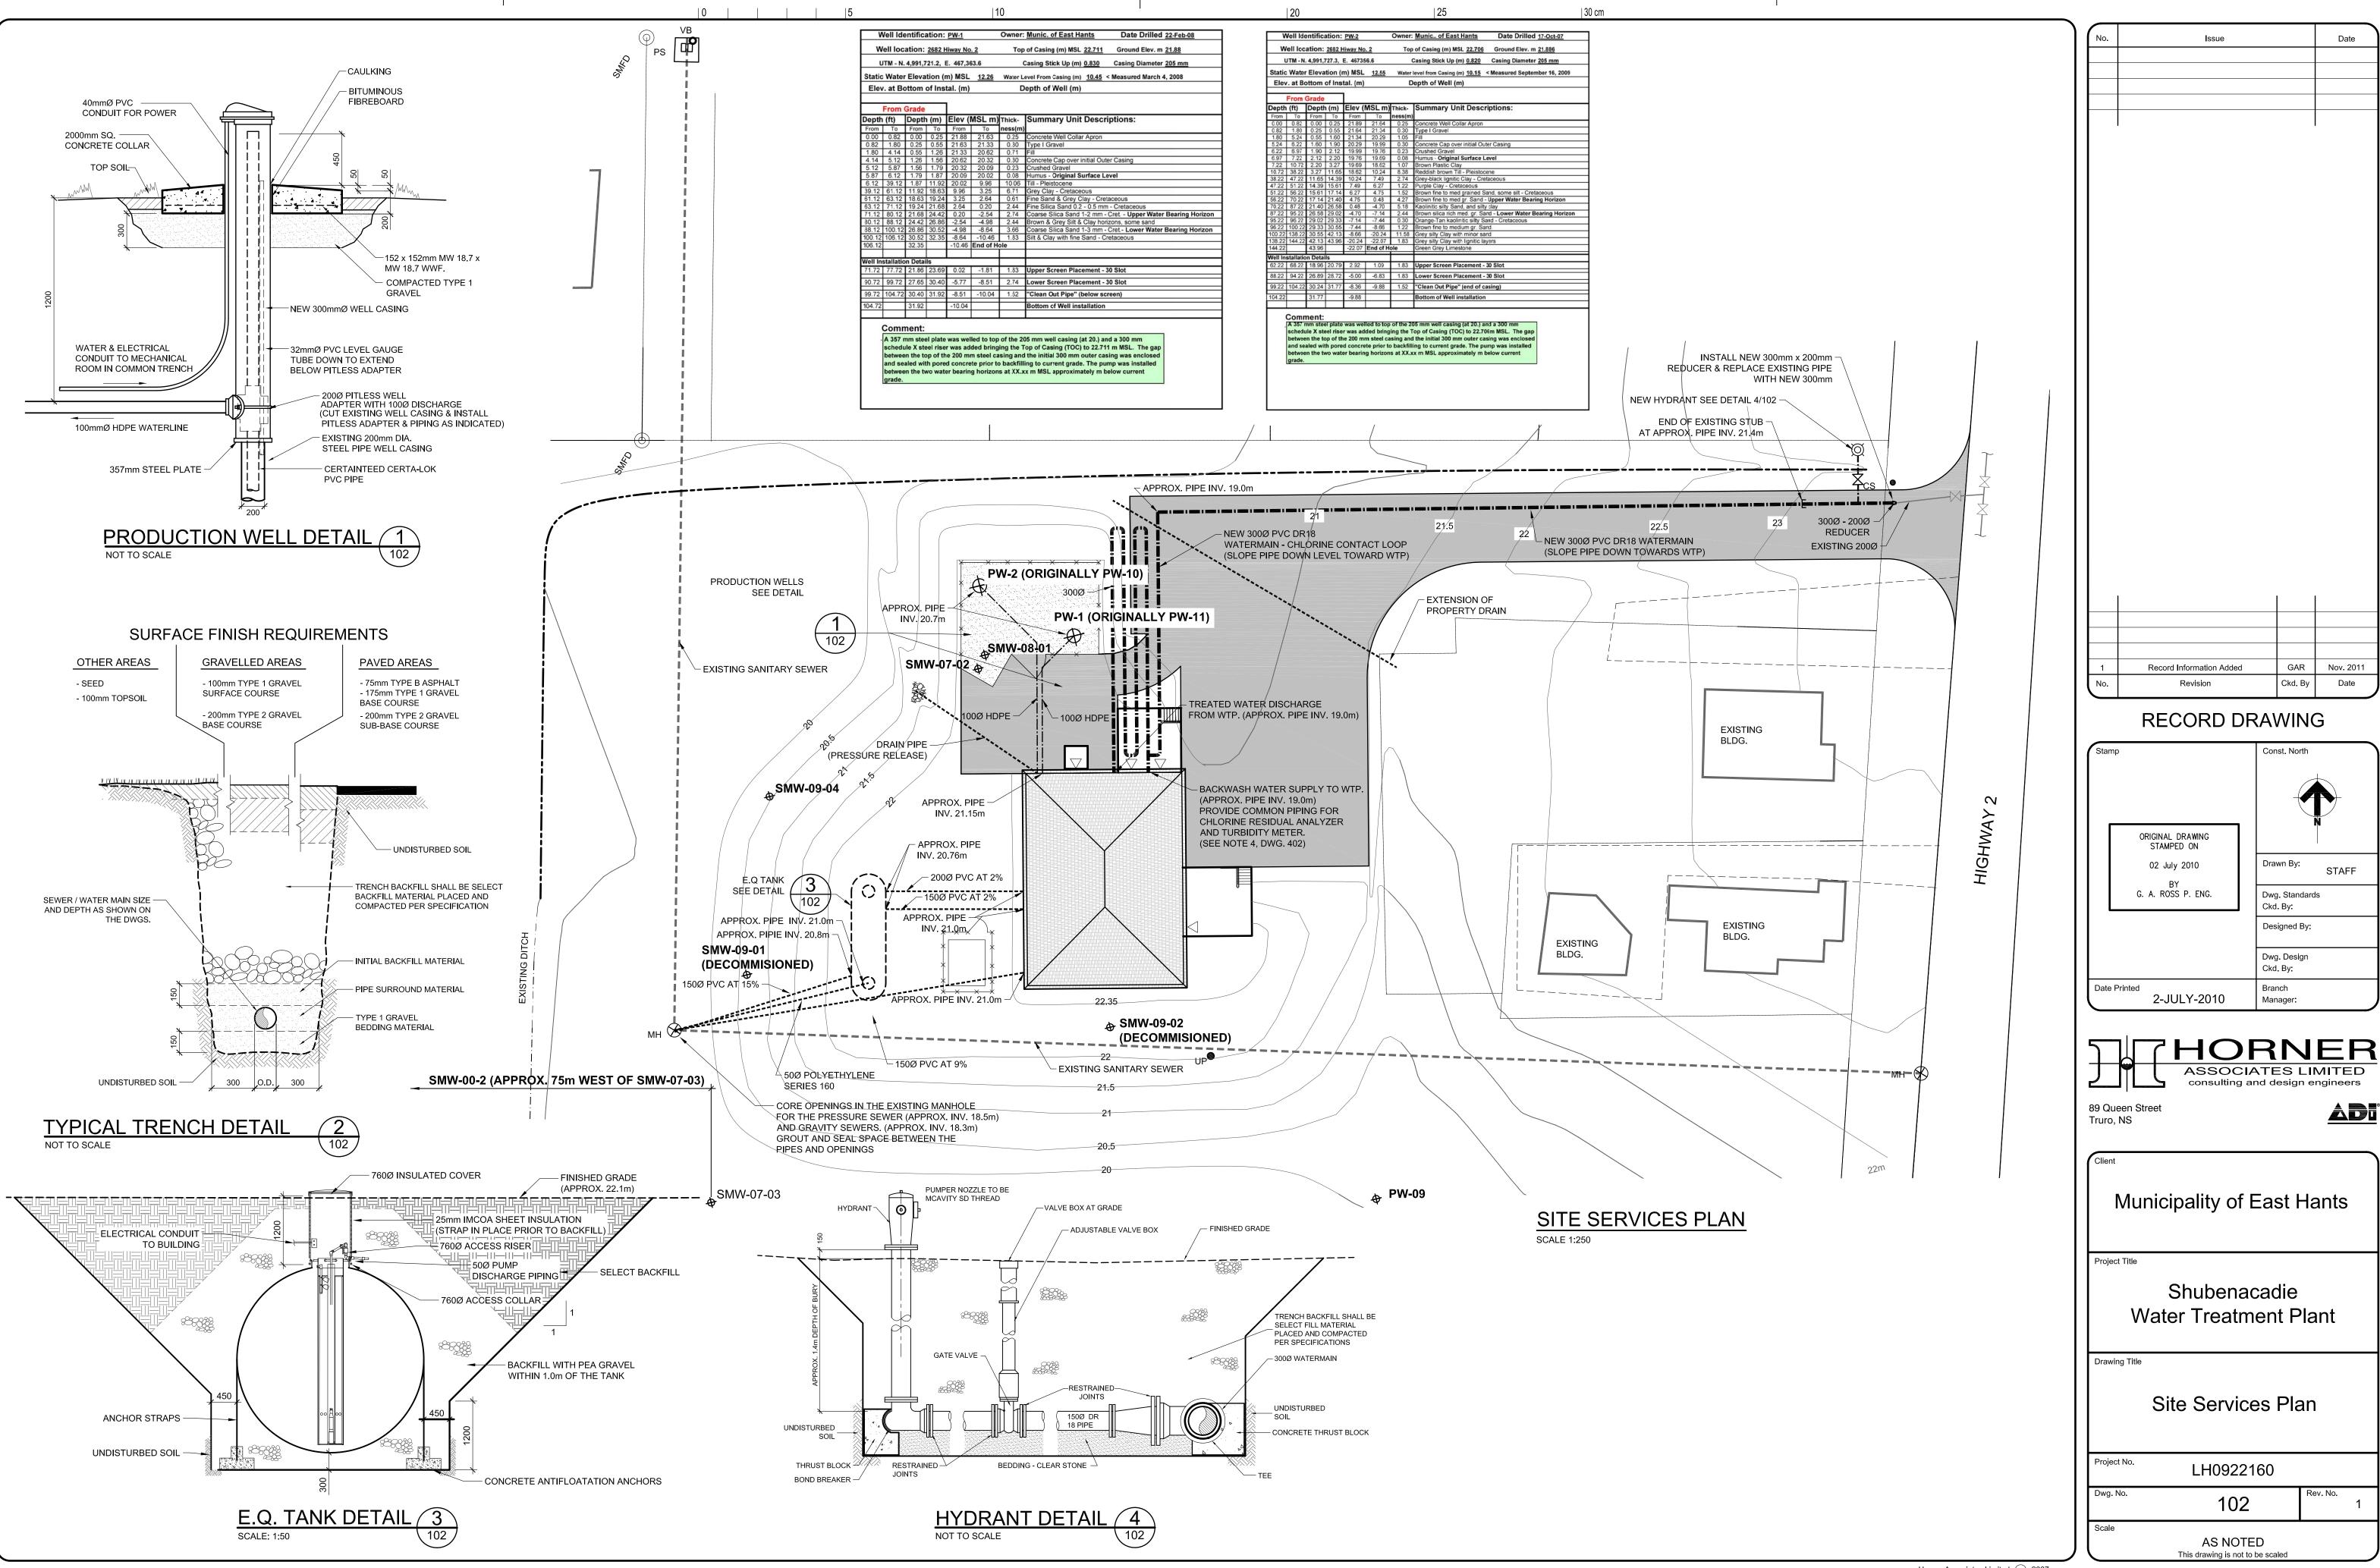

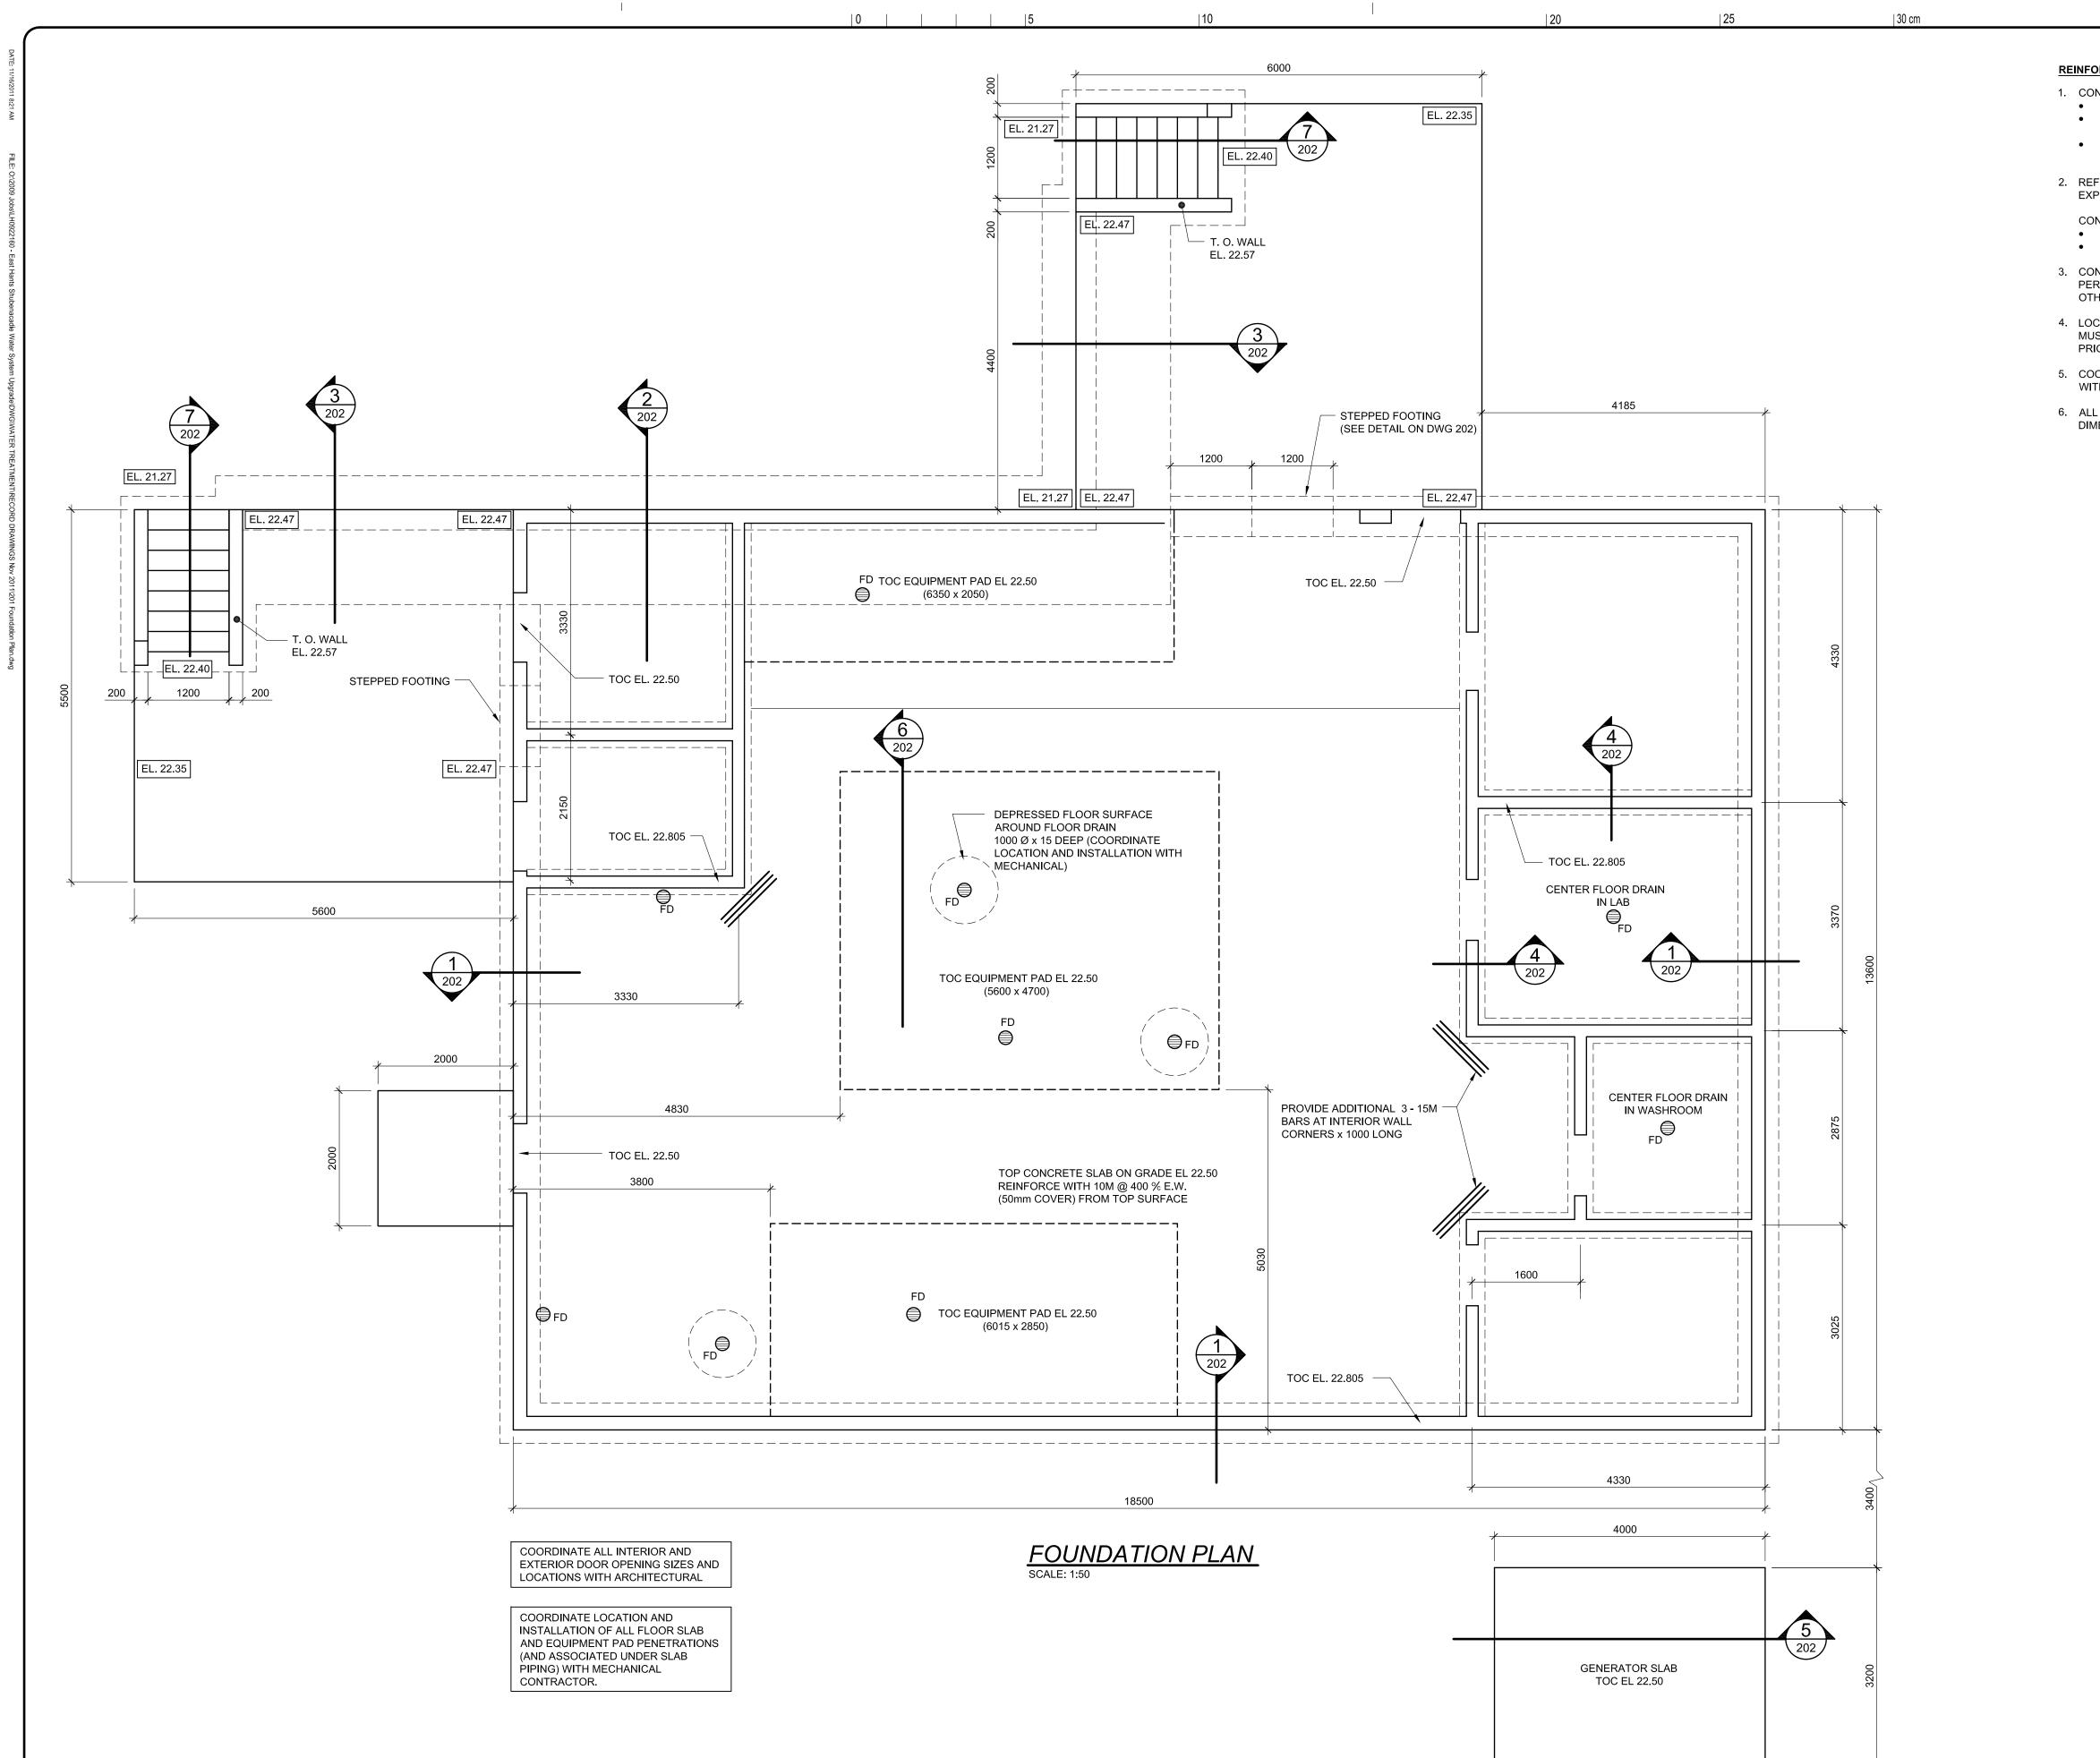

# REINFORCED CONCRETE NOTES

CONCRETE DESIGN STRENGTHS

 fc = 25 MPa (AT 28 DAYS) FOR ALL FOOTINGS
 fc = 30 MPa (AT 28 DAYS) FOR ALL FOUNDATION WALLS AND INTERIOR SLAB ON GRADE.
 fc = 32 MPa (AT 28 DAYS) FOR EXTERIOR SIDEWALKS, EQUIPMENT PADS, ETC

2. REFER TO SPECIFICATIONS FOR CONCRETE EXPOSURE AND CONCRETE MIX DESIGN DETAILS.

CONCRETE COVER REQUIREMENTS
60mm - WALLS AND FOOTING
75mm - CONCRETE CAST AGAINST EARTH

3. CONCRETE REINFORCING LAP SPLICES AND DETAILS PER RSIC MANUAL LATEST EDITION UNLESS OTHERWISE NOTED.


4. LOCATIONS OF ALL VERTICAL CONSTRUCTION JOINTS MUST BE APPROVED, IN WRITING, BY THE ENGINEER PRIOR TO CONSTRUCTION.

5. COORDINATE LOCATION OF ALL EMBEDDED PARTS WITH APPROPRIATE TRADE.

6. ALL ELEVATIONS ARE SHOWN IN METERS. ALL DIMENSIONS ARE SHOWN IN MILLIMETERS.

Issue		Date
	ļ	
Record Information Added	GAR	Nov. 2011

# RECORD DRAWING

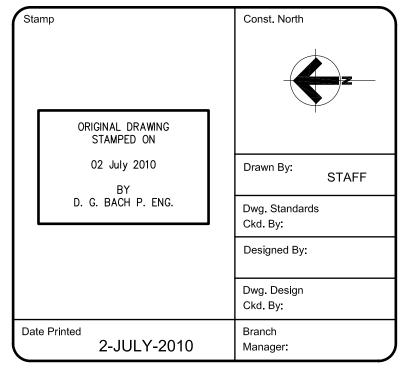



Client Municipality of East Hants

Project Title

Dwg. No.

# Shubenacadie Water Treatment Plant

Rev. No.

Foundation Plan


Project No. LH0922160

LI 10922 10

201

**1:50** This drawing is not to be scaled

I

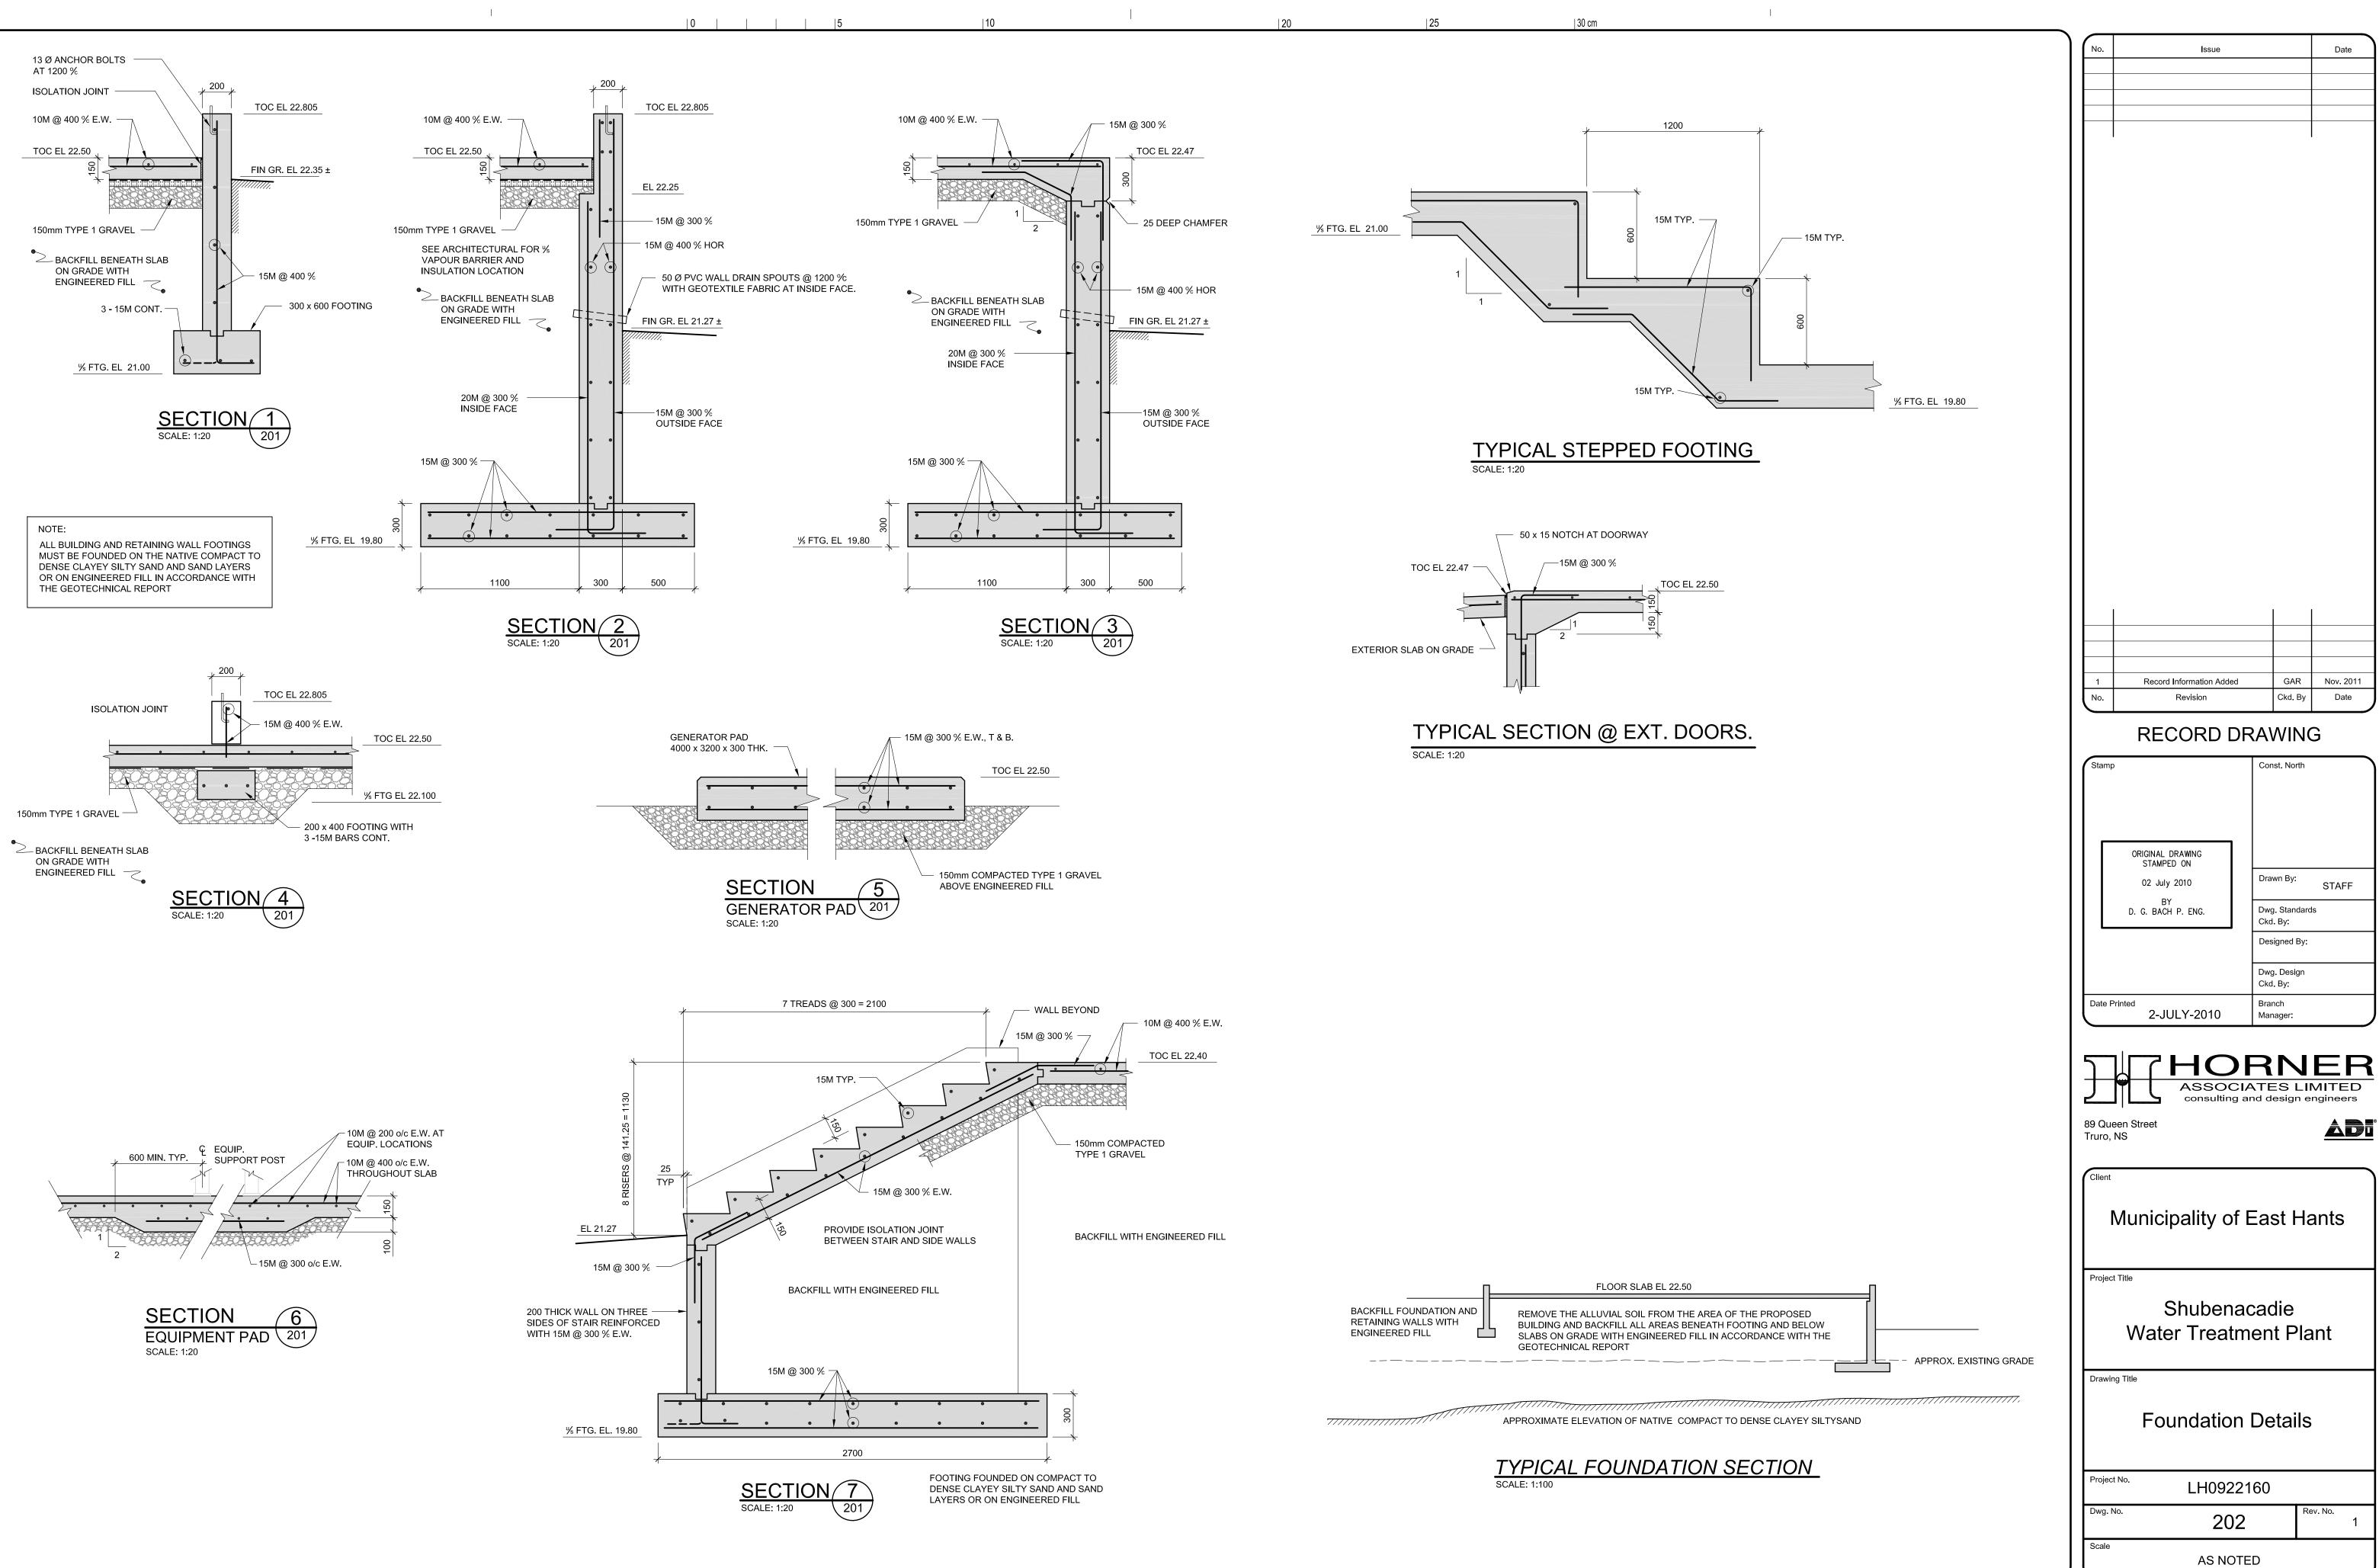


<u> </u>			
<u> </u>			
1	Record Information Added	GAR	Nov. 2011
No.	Revision	Ckd. By	Date
1			i <b>/</b>

Stamp	Const. North
ORIGINAL DRAWING STAMPED ON	
02 July 2010	Drawn By: STAFF
BY D. G. BACH P. ENG.	Dwg. Standards Ckd. By:
	Designed By:
	Dwg. Design Ckd. By:
Date Printed 2-JULY-2010	Branch Manager:
2-3011-2010	

Municipality of East I	Hants
Project Title Shubenacadie Water Treatment F	Plant
Drawing Title Foundation Detai	ils
Project No. LH0922160	
Dwg. No. 202	Rev. No. 1

This drawing is not to be scaled



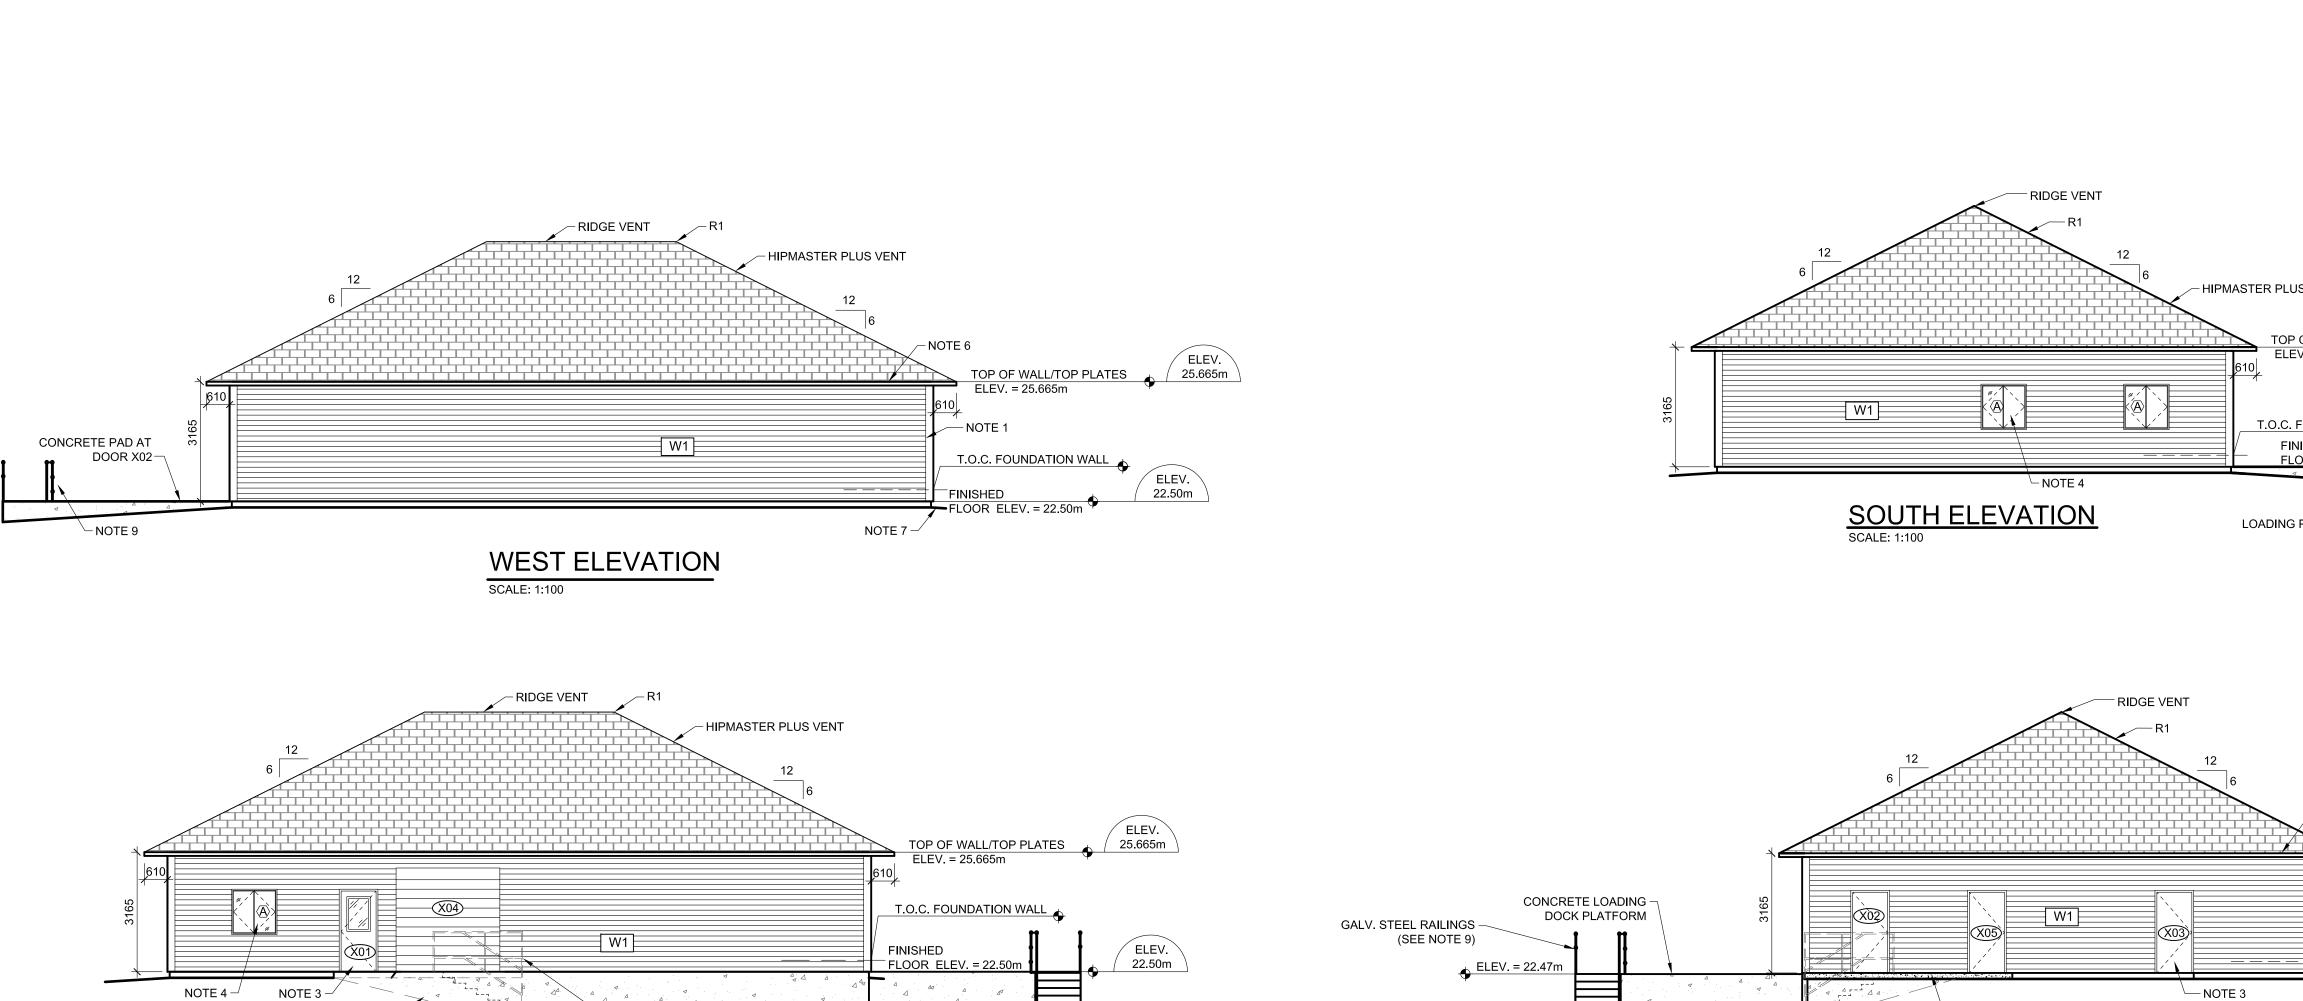


|10

		FLOOR ELEV. = 22.50m	
NOTE 3			
GRADE LINE EAST OF DOCK	GALV. GUARDRAILS/HANDRAILS	ETAINING WALL	
	EAST ELEVATION (EAST OF BLDG.) AT LOADING DOCK (SEE NOTE 9)		
S	CALE: 1:100		~

I

WINDOW SCHEDULE (NEW WINDOWS)										
	WINDO	WS (HIGH	PERFORM	ANCE LC	W E "ENERGLA	SS")		FRAM	IES	REMARKS
MARK	W <b>I</b> DTH (mm)	HEIGHT (mm)	GLASS THICKNESS (mm)	TINTING	TYPE	SASH OPERATION	MATERIAL	FINISH	QUANTITY	
	1220	1220	25	BRONZE	LOW E (ENERGLAS)	OPERABLE CASEMENT	PVC	WHITE	3	DOUBLE GLAZED
					NOTES					
CERTIF FOR TH ALL WII ENSUR PROVIE REQUIF PROVIE	ications ie geogr Ndows SI e All Win de All Net Red. de Wide C	AND HAVE APHIC LOCA HALL BE HEA DOW OPEN CESSARY J OMMERCIAI	AN ENERGY ATION. AVY DUTY C INGS ARE FF NAILING TRI _ FRAME PR	RATING O OMMERCIA RAMED TO MS, BRICK OFILES FO	F 25 MIN. ENSURE . AL GRADE SUPREM COINCIDE WITH W	ALL WINDOW F IE AS MANUFAG INDOW MANUF ORIES & DRYW	RAMES & ( CTURED B' ACTURER'	GLAZING M Y KOHLER S ROUGH	IEET ALL REG INTERNATIO STUD/MASON	CURRENT CWDMA QUIRED WIND LOAD C NAL LTD. OR EQUIVAI NRY OPENING SIZES. .L & EXTENSIONS AS



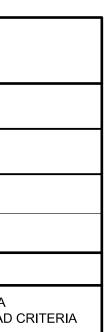

D CRITERIA VALENT. ES. AS

# NOTES:

• ELEV. = 21.27m

1. 19mm x 89mm HARDIE BOARD OUTSIDE CORNERS & HORIZONTAL TRIMS (TYP.)

2. SEE ELECTRICAL DRAWINGS FOR EXTERIOR LIGHTING FIXTURE TYPES & LOCATIONS.

3. ALL EXTERIOR DOORS TO BE FRAMED FOR A 914mm WIDE x 2135mm HIGH EXTERIOR INSULATED HOLLOW METAL DOOR & TB PSF. (CONFIRM ON SITE)

4. CONTRACTOR TO CONFIRM ALL WINDOW / LOUVER SIZES & RSO PRIOR TO FABRICATION / SUPPLY OF NEW PRODUCTS.

5. PRE FINISHED SIDING, FASCIAS, SOFFITS, & TRIMS, ACCESSORIES BY JAMES HARDIE SIDING PRODUCTS. COLOURS BY OWNER.

6. PROVIDE COMMERCIAL GRADE PREFINISHED GUTTERS & DOWNSPOUTS & ACCESSORIES (127mm Ø MIN) AS REQUIRED TO MATCH BUILDING FINISHES. PROVIDE QUANTITY OF DOWNSPOUTS AS REQUIRED TO FACILITATE DRAINAGE FROM ROOF.

7. PROVIDE CONCRETE SPLASH BLOCKS AT BOTTOM OF ALL DOWNSPOUTS.

8. FOR WALL SECTIONS REFER TO DWG. 304.

9. GALV. ROUND PIPE, DM48.3 x 5.08 FOR RAILS (TOP & INTERMEDIATE) & POSTS (MAX SPACING 1220mm BETWEEN POSTS). SECURE PIPE TO 90 x 90 x 200 x 10mm THICK GALV. PLATES AT PIPE BASE & WAGNER BRACKETS @ SIDE WALL MOUNTING. SECURE TO CONCRETE WITH 13mm Ø S/S ANCHOR ROD BONDED WITH HILTI HIT-HY 150 MAX. ADHESIVE WITH 75mm EMBEDMENT. PIPE TO ASTM A53 GRADE B.

# LEGEND:

T.O.C. - TOP OF CONCRETE

- TB THERMALLY BROKEN RSO - ROUGH STUD OPENING
- ELEV. ELEVATION
- FIN. FINISHED
- C/W COMPLETE WITH PSF - PRESSED STEEL FRAME

(X02) - DOOR IDENTIFICATION MARKER (SEE DOOR SCHEDULE DWG. 305)

 $\langle \overline{A} \rangle$  - WINDOW IDENTIFICATION (SEE WINDOW SCHEDULE THIS DWG.)

# **R1 - TYPICAL ROOF CONSTRUCTION**

- CONCRETE PAD

NORTH ELEVATION SCALE: 1:100

- GRADE LINE NORTH OF CONCRETE PAD | 30 cm

25


30 yr ASPHALT SHINGLES (COLOUR BY OWNER) ASPHALT ROLL ROOFING ICE & WATER SHIELD 16mm T&G PLYWOOD SHEATHING PRE-ENGINEERED WOOD TRUSS @ 610 c/c PROVIDE STRAPPING AS REQUIRED FOR ROOF TRUSS STABILITY RSI 7.0 (R40) BATT INSULATION 0.15mm (6MIL) POLY VAPOUR BARRIER MEMBRAN 19mm x 89mm STRAPPING @ 410 c/c 16mm TYPE 'X' DRYWALL (PRODUCT MUST BE SUITABLE FOR HUMID / DAMP CONDITIONS)

## W-1 EXTERIOR WALL LEGEND:

HORIZ. SIDING (FIBRE CEMENT-PREFINISHED SIDI 38 x 64 P. T. VERT. WOOD STRAPPING @ 410mm c/ (AT STUD LOCATIONS) AIR BARRIER MEMBRANE (SEAL / TAPE ALL JOINT 13mm EXTERIOR GRADE PLYWOOD 38 x 140 WOOD STUDS @ 410mm c/c PROVIDE HORIZONTAL STUD BLOCKING @ <sup>1</sup>/<sub>3</sub> SPA RSI 4.23 (R24) BATTS INSULATION 16mm CGC TYPE 'X' AQUATOUGH GYPSUM BOARE 16mm CGC TYPE 'X' GYPSUM BOARD (RMS. 102,10

	No.	Issue		Date
LUS VENT				
P OF WALL/TOP PLATES				
EV. = 25.665m				
INISHED ELOOR ELEV. = 22.50m				
G PLATFORM BEYOND				
NOTE 6	1	Record Information Added	GAR	Nov. 2011
TOP OF WALL/TOP PLATES ELEV. = 25.665m	No.	Revision	Ckd. By	Date
610 610		RECORD DF	RAWING	G
NOTE 1			T	
T.O.C. FOUNDATION WALL	Stamp		Const. North	
FINISHED				
FLOOR ELEV. = 22.50m NOTE 7				
		ORIGINAL DRAWING STAMPED ON		
		02 July 2010		
		BY G. A. ROSS P. ENG.	Drawn By:	STAFF
		G. A. RUSS F. ENG.	Dwg. Standard	ls
			Ckd. By: Designed By:	
			Designed by.	
			Dwg. Design Ckd. By:	
	Date Pr	inted	Branch	
			Manager:	/
		1		
NE			RN	ER
	「丁	ASSOCIA consulting a	ATES LI	MITED
			ucaign e	
	89 Que Truro, N	en Street NS		àdi
DING)				
c/c	Client			
TS)	.		<b>-</b>	
AN		lunicipality of	⊨ast H	ants
RD U/N (RMS. 101)				
03,104,105, 106, 107)	Project	Title		
		Shubenad		- 1
		Water Treatm	ent Plar	11
	Drawing	g Title		
			<u>1</u>	-
		Building Ele	evation	S
	Project	No.	4.0.0	
		LH0922		No.
	Dwg. N	<sup></sup> 301	Re	ev. No. 1
	Scale	1:100		
		This drawing is not to	be scaled	



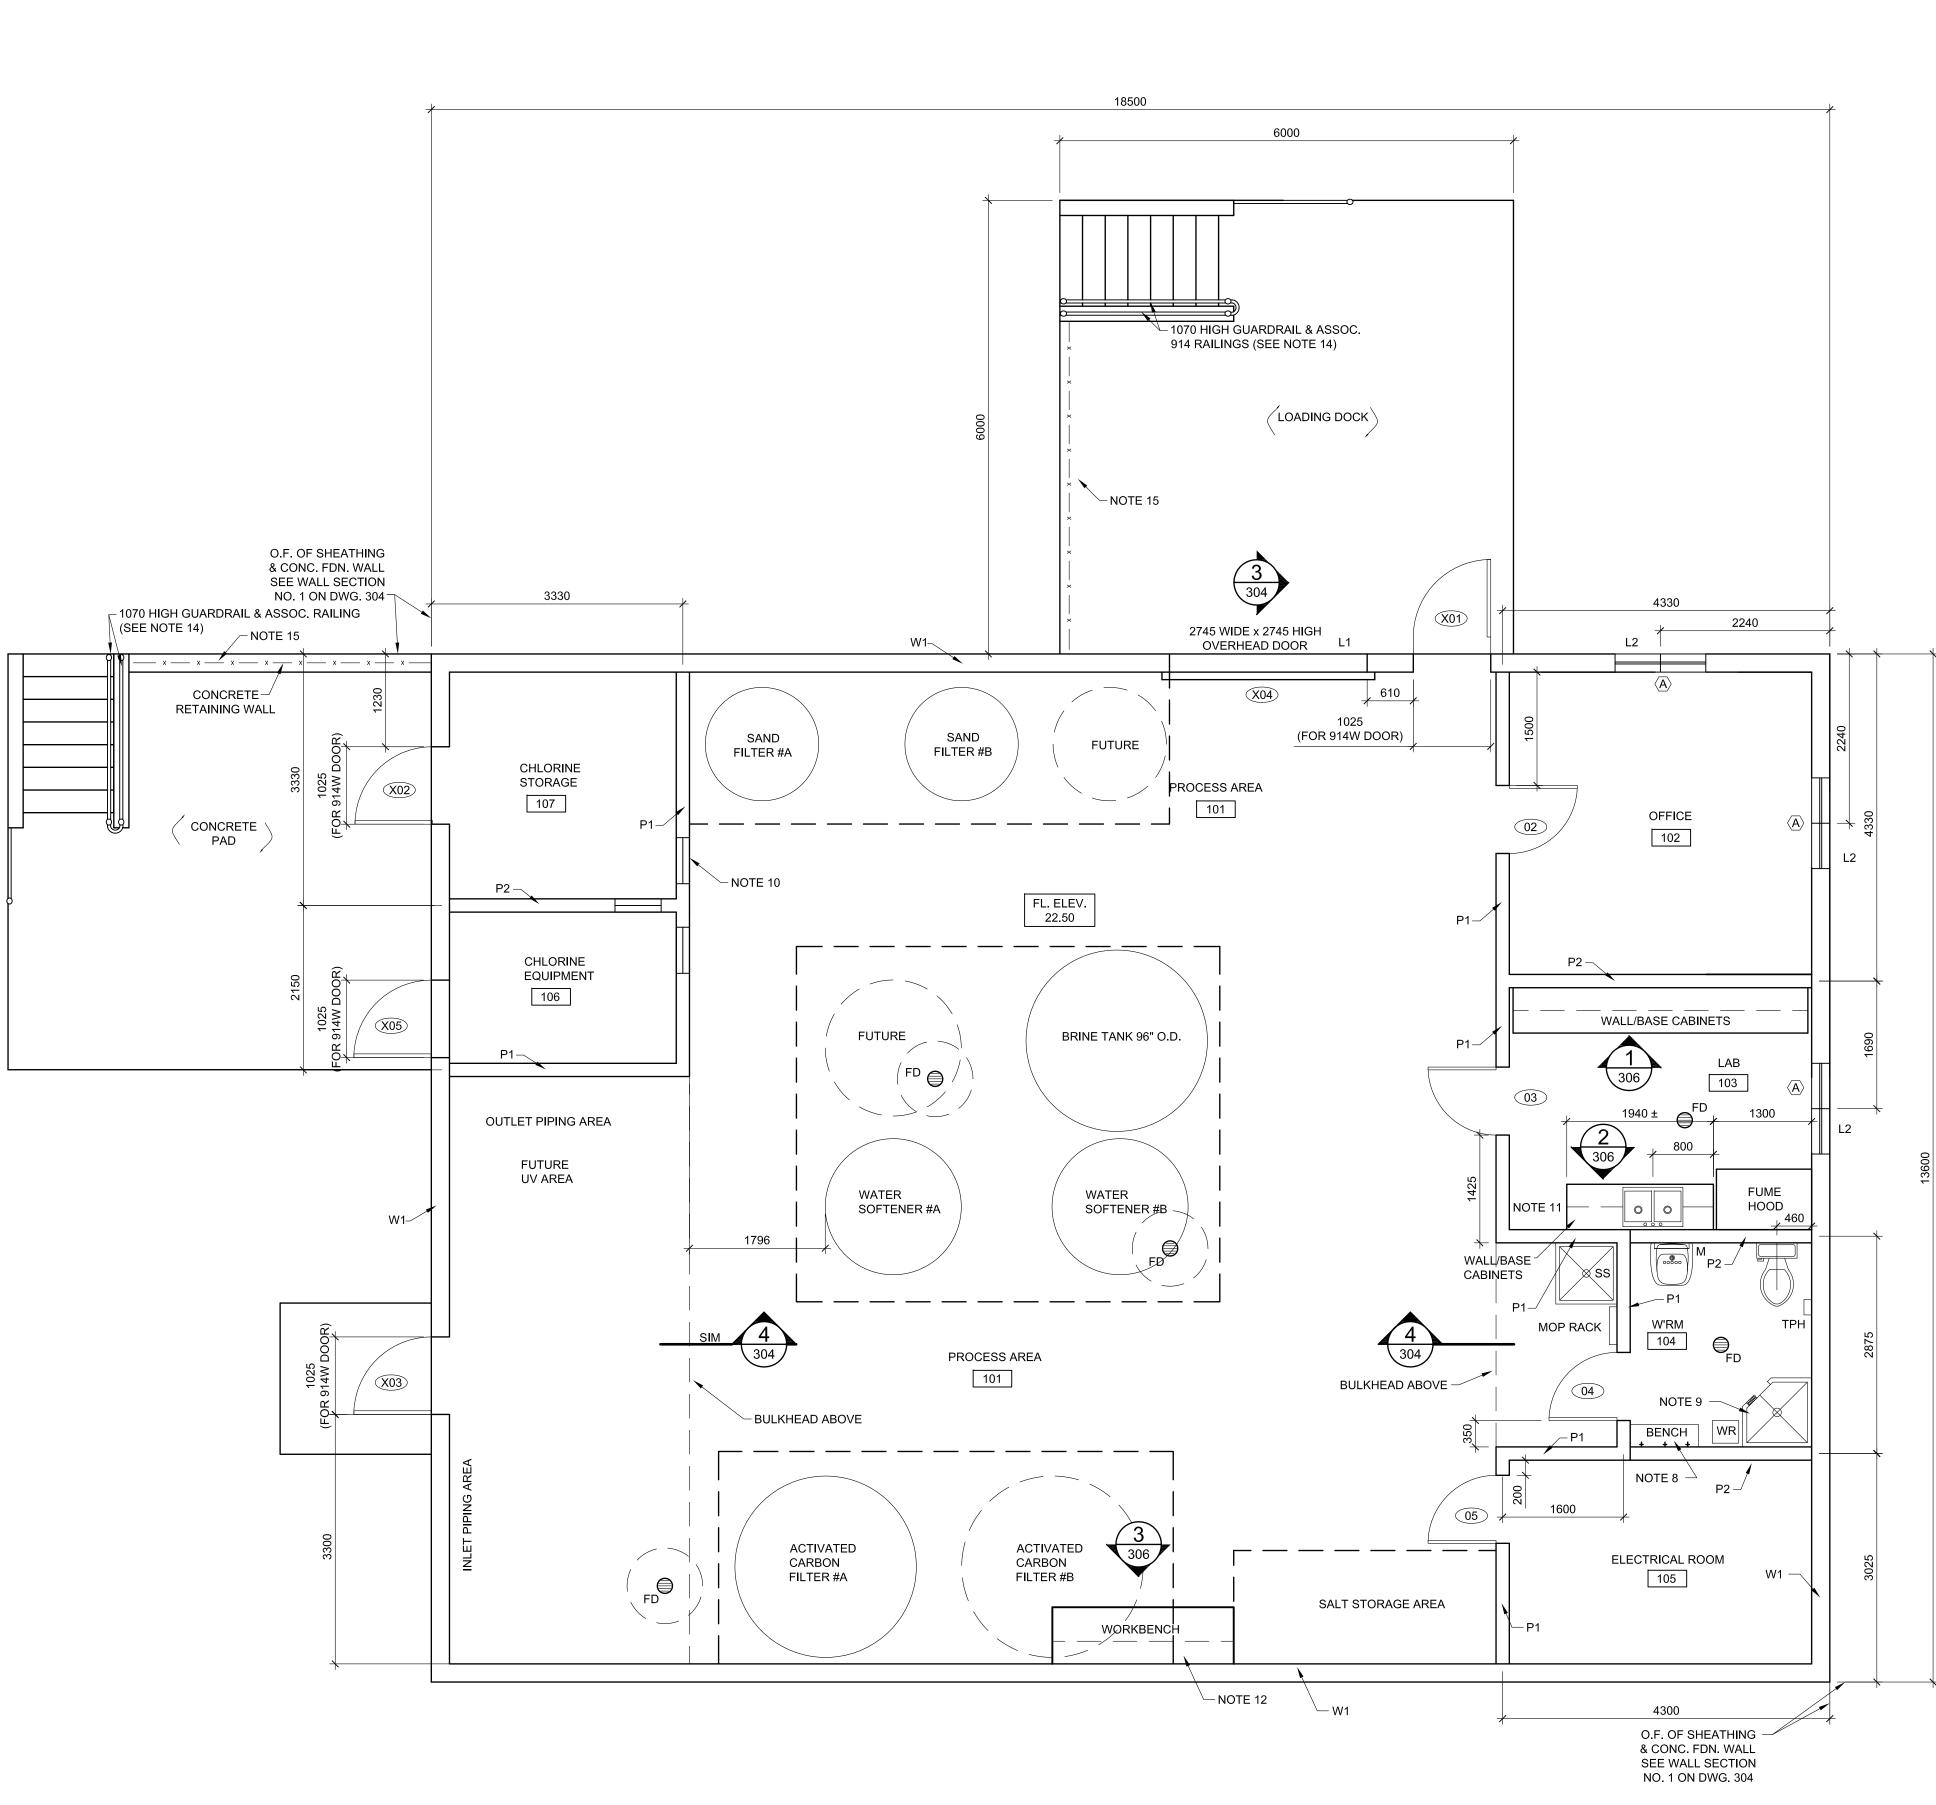

**BUILDING FLOOR PLAN** SCALE: 1:50

I



30 cm						
					No. Issue	Date
WOOD FRAMING NOTES:						
	• A - 086 - 01 "ENGINEERED DES	SIGN IN WOOD (LIMI	STATES DESIGN)"			
2. MATERIAL SPECIFICA	TIONS,	, ,	,			
PARALLAM PSL - 2.0 E	P-F (GRADE STAMP ON EACH	PIECE)				
	OR DRILL HOLES IN PARALLA SE 16mm T & G SHEATHING A					
SPACED AT 150mm CE CENTER ALONG INTEF	ENTER TO CENTER ALONG SU RMEDIATE TRUSSES.	IPPORTED PANEL EI	NDS AND AT 305mm CENTER TO			
75mm NAILS SPACED / 305mm CENTER TO CE	AT 150mm CENTER TO CENTE ENTER ALONG INTERMEDIATE	R ALL AROUND PER WALL STUDS.				
<ul> <li>REGISTERED OR LICEI</li> <li>SHOW PITCH, CHAMBE</li> <li>INDICATE SPECIES, SI</li> <li>INDICATE CONNECTOF</li> <li>SHOW BEARING DETA</li> <li>INDICATE DESIGN LOA INCREASE.</li> <li>SHOW LOCATION AND</li> <li>INCLUDE LAYOUT DRA IDENTIFICATION OF EA</li> </ul>	NSED IN NOVA SCOTIA, TO THER, CONFIGURATION, AND SP ZES, AND STRESS GRADES C R TYPES, THICKNESSES, SIZE ILS. AD FOR EACH TRUSS MEMBER SIZES OF LATERAL BRACING WING SHOWING LOCATION C	HE ENGINEER FOR F PACING OF TRUSSES OF LUMBER USED AS ES, LOCATIONS, AND R; INDICATE ALLOW FOR COMPRESSIO DF EACH INDIVIDUAL	5 TRUSS MEMBERS. D DESIGN VALUES. ABLE LOAD AND STRESS N MEMBERS.			
6. LIMIT LIVE LOAD DEFL	ECTION TO 1 / 360th OF SPAN		DEFLECTION TO 1 / 240th OF			
	ICANE ANCHORS AT EACH EI PACITY FOR EACH ANCHOR T		AND ROOF RAFTERS. MINIMUM			
	WOOD LINTE					
NO.	SIZE	MAX.	REMARKS 3 JACK STUDS			
L1	PSL 133 x 229 (5 1/4" x 9")	2800mm	3 KING STUDS DOUBLE JACK STUDS,	-		
L2	3 - 38 x 184	1500mm	DOUBLE KING STUDS			
W1 - EXTERIOR WALL LE	GEND:		LEGEND:			
HORIZ. SIDING (FIBRE CE	MENT-PREFINISHED SIDING)	01	DOOR IDENTIFICATION (REFER TO	DOOR		
(AT STUD LOCATIONS)	9 STRAPPING @ 410mm c/c E (SEAL / TAPE ALL JOINTS)	$\langle \overline{A} \rangle$	SCHEDULE DWG.305) WINDOW IDENTIFICATION MARKER			
13mm EXTERIOR GRADE 38 x 140 WOOD STUDS @	PLYWOOD 410mm c/c	_	TO WINDOW SCHEDULE DWG. 301)		1 Record Information Adde	d GAR Nov. 2011
RSI 4.23 (R24) BATTS INSU	TUD BLOCKING @ ½ SPAN ULATION ATOUGH GYPSUM BOARD U/N	[101] (BMS_101)	ROOM NUMBERS ABBREVIATIONS:		No. Revision	Ckd. By Date
	SUM BOARD (RMS. 102,103,104		BS - BUILDING SECTION C/C - CENTER TO CENTER SPAC		RECORD	
			CONC - CONCRETE C/W - COMPLETE WITH			_
P1 - INTERIOR PARTITION 16mm CGC TYPE 'X' AQUA ONLY, ON ONE SIDE OF 3	ATOUGH PROCESS 101 SIDE		DWG DRAWING FD - FLOOR DRAIN FDN FOUNDATION		Stamp	Const. North
	BLOCKING AT 1/3 SPAN. 16mn		F - FRIDGE (NIC) GR - GUARD RAIL (1070mm HIG	iH MIN.)		
103, 104, 105, 106, 107 (1 F	OARD FOR INSIDE OF RMS 10 HR FIRE SEPARATION)	Ζ,	HORIZ HORIZONTAL LI - LINTEL DESIGNATIONS LSD - LIQUID SOAP DISPENSER		ORIGINAL DRAWING STAMPED ON	Τ
	SUM BOARD EACH SIDE OF		LSD - LIQUID SOAP DISPENSER M - MIRROR M. O MASONRY OPENING		02 July 2010	Drawn By: STAFF
38 x 140 WOOD STUDS @ TO U/S OF ROOF TRUSSE BLOCKING AT 1/3 SPAN.	ES ABOVE.PROVIDE HORIZ.		NIC - NOT IN CONTRACT O/F - OUTSIDE FACE	_	BY G. A. ROSS P. ENG.	Dwg. Standards Ckd. By:
(1 HR FIRE SEPARATION)			P1 - INTERIOR PARTITION TYP PTD - PAPER TOWEL DISPENSE RH - ROBE HOOK			Designed By:
GENERAL NOTES:			SS - SLOP / SERVICE SINK TPH - TOILET PAPER HOLDER			Dwg. Design Ckd. By:
<ol> <li>REFER TO DRAWING 3 &amp; DETAILS.</li> </ol>	306 FOR MILLWORK ELEVATIO	NS, LOCATIONS,	U/C - UNDER CABINET U/S - UNDERSIDE W1 - EXTERIOR WALL TYPE		Date Printed	Branch
2. INSTALL 50mm WIDE A RAISED CONC. PADS/C	DHESIVE HIGHLIGHT STRIP A CURBS.	T EDGE OF	WR - WASTE RECEPTACLE WS - WALL SECTION		2-JULY-2010	Manager:
	FOR MECHANICAL LOUVER DE	ETAILS.		_		RNER
COMMUNICATIONS PA	OOD (GIC) BACKERBOARDS F NELS. PAINT WITH FIRE RESI WITH ELECTRICAL EQUIPMEN	STANT PAINT.			ASSO	CIATES LIMITED g and design engineers
5. REFER TO DWG. 305 F SCHEDULE.	OR DOOR SCHEDULE & ROOM	M FINISH			9 Queen Street ruro, NS	
TO STABILIZE & MAKE	L BRACING, BRACKETS AS RE RIGID ALL NEW INTERIOR PA	RTITIONS.			Client	
DUCTWORK & PIPES.					Municipality	of East Hanta
	LONG HARDWOOD BENCH W LL. SEE DETAIL B ON DWG. 30				Municipality c	n East Hants
(CURTAIN, ROD, HOOK					Project Title	
	INTERIOR BORROWED LITES STEEL FRAMES. SEE DOOR S				Shuben	acadie
	STATION. (HAWS MODEL 8300	))			Water Treat	ment Plant
	FOR WORKBENCH DETAILS. Omm INSULATED ATTIC HATCH	4.				
LOCATION TO BE DET	ERMINED.				Drawing Title	
& POSTS (MAX SPACIN TO 90 x 90 x 200 x 10m WAGNER BRACKETS ( CONCRETE WITH 13mr	M48.3 x 5.08 FOR RAILS (TOP ) NG 1220mm BETWEEN POSTS) m THICK GALV. PLATES AT PII @ SIDE WALL MOUNTING. SEC m Ø S/S ANCHOR ROD BONDE SIVE WITH 75mm EMBEDMEN	). SECURE PIPE PE BASE & CURE TO ED WITH HILTI			Floor	Plan
15.PROVIDE FLOURESCE	NT GALV. SAFETY CHAIN c/w /				Project No. LH092	2160
	OANGER SIGN" AT NORTH LOA OR CONC. PAD AT CHLORINE				Dwg. No. 30	2 Rev. No. 1
					Scale	

- -5


- 8.

- 15 E

ORIGINAL DRAWING STAMPED ON 02 July 2010	Drawn By: STAFF
BY G. A. ROSS P. ENG.	Dwg. Standards Ckd. By:
	Designed By:
	Dwg. Design Ckd. By:
Date Printed 2-JULY-2010	Branch Manager:
51/C240	DRNER
ASSO	CIATES LIMITED

**1:50** This drawing is not to be scaled



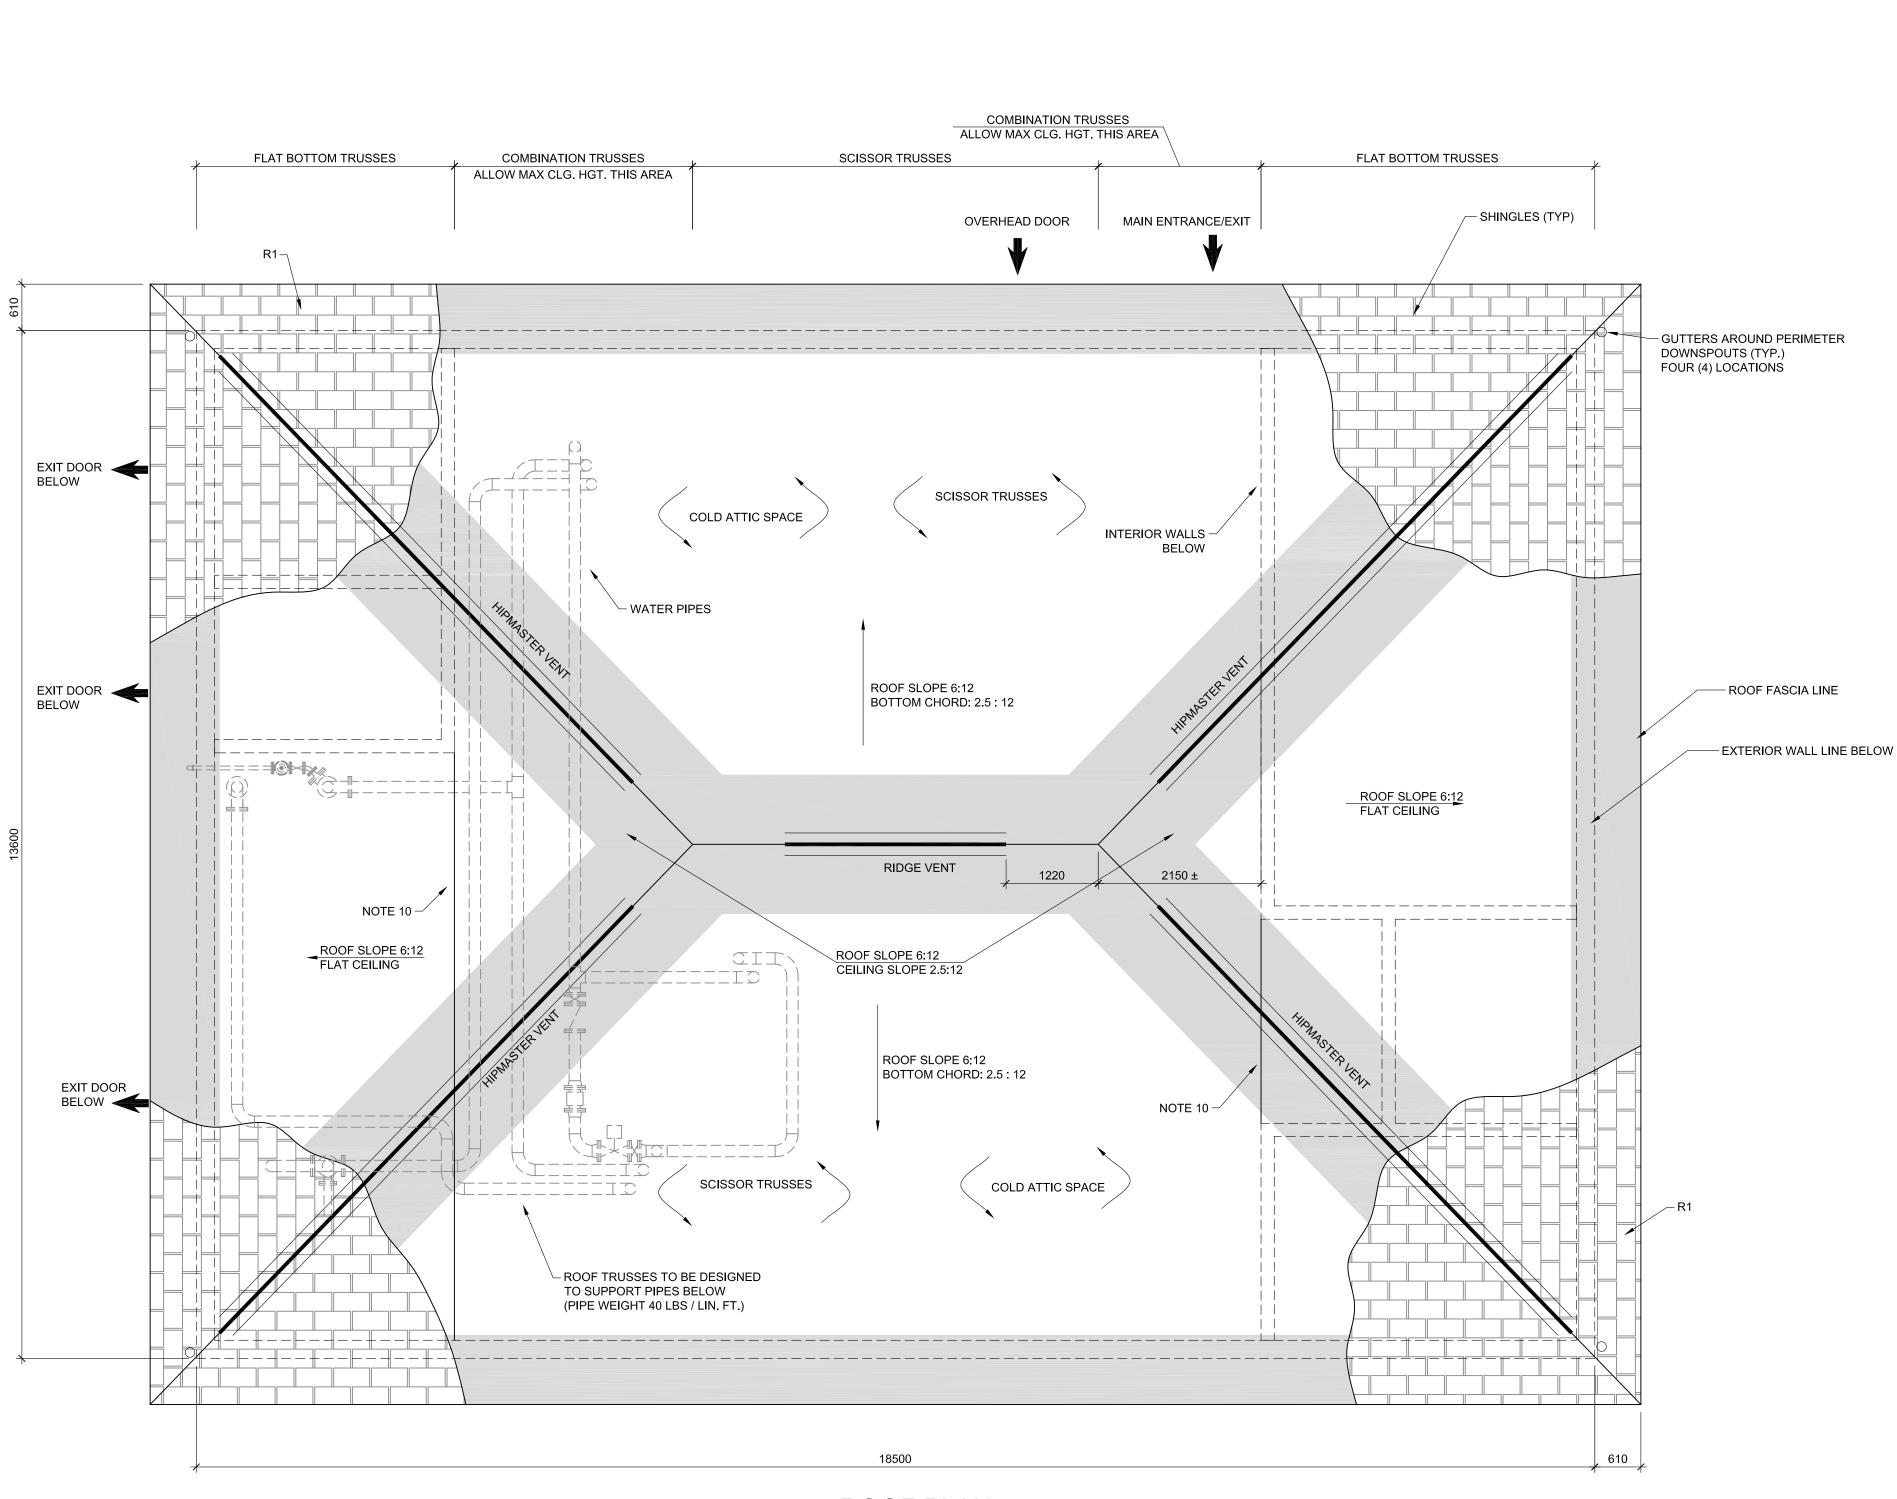

ROOF PLAN SCALE: 1:50

1




20

25


| 30 cm

1



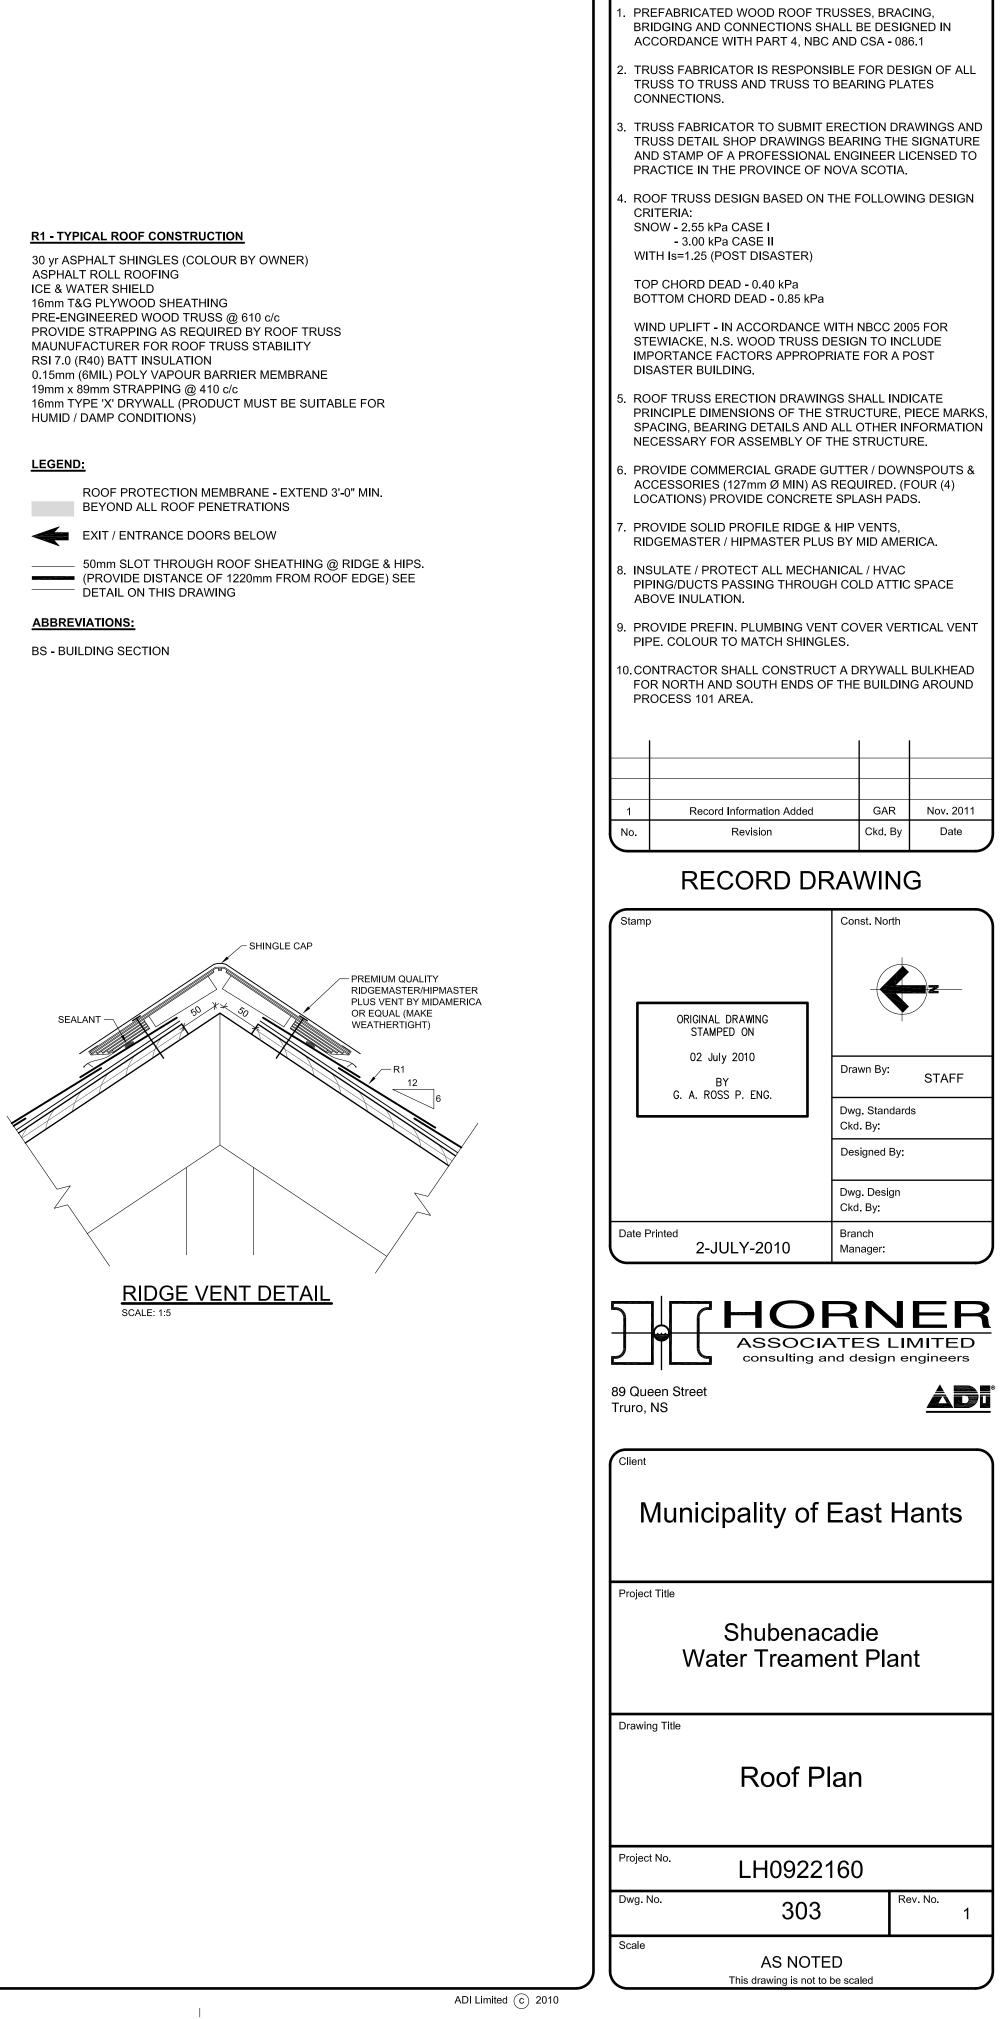

NOTES:

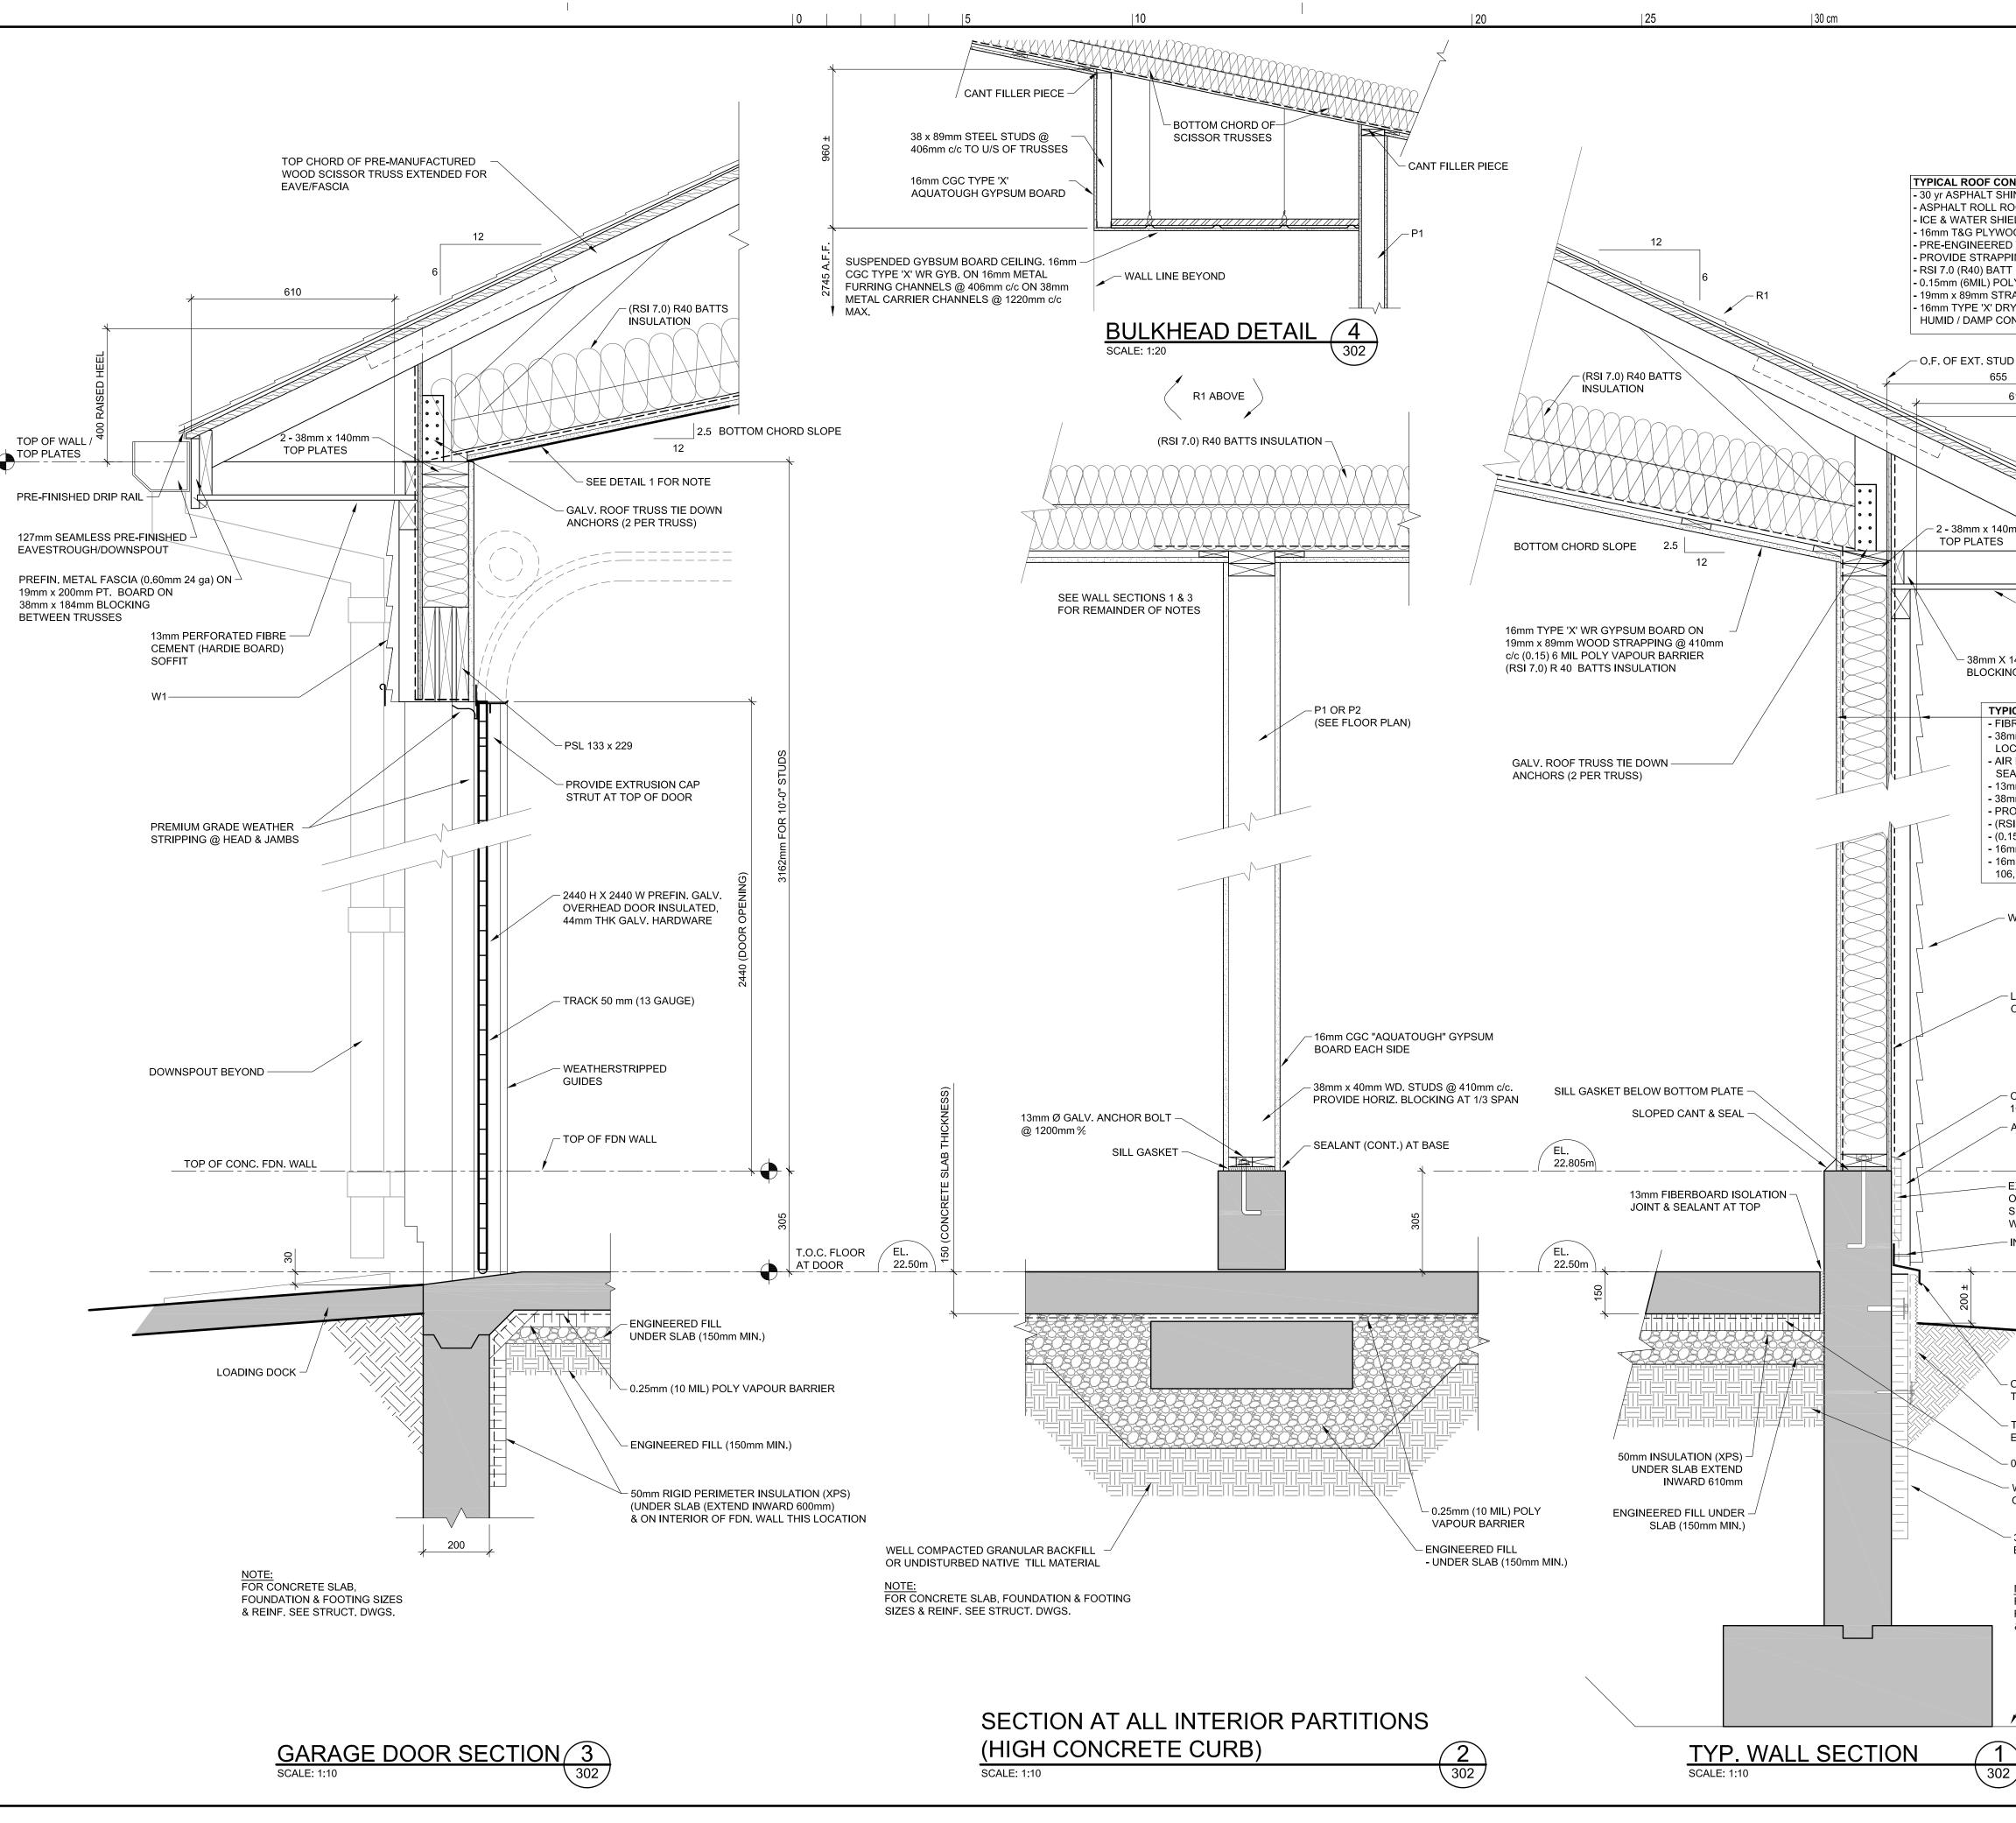

	No.	Issue		Date
ROOF CONSTRUCTION - R1 PHALT SHINGLES (COLOUR BY OWNER) T ROLL ROOFING (ATER SHIELD &G PLYWOOD SHEATHING GINEERED WOOD TRUSS @ 610 c/c DE STRAPPING AS REQUIRED FOR ROOF TRUSS STABILITY (R40) BATT INSULATION (6MIL) POLY VAPOUR BARRIER MEMBRANE 89mm STRAPPING @ 410 c/c YPE 'X' DRYWALL (PRODUCT MUST BE SUITABLE FOR / DAMP CONDITIONS)				
EXT. STUD O.F. OF TOP CHORD				
<u>655</u> 610				
Bmm x 140mm PLATES				
- 38mm X 140mm WOOD BLOCKING AS REQ'D (HARDIE BOARD) SOFFIT				
TYPICAL EXTERIOR WALL CONSTRUCTION - W1         - FIBRE CEMENT PREFINISHED SIDING (HARDIEBOARD)         - 38mm x 64mm PT VERTICAL STRAPPING @ 410mm o/c AT STUD LOCATIONS         - AIR BARRIER MEMBRANE (TYVEK COMMERCIAL GRADE SEAL/TAPE ALL JOINTS)         - 13mm EXTERIOR GRADE PLYWOOD SHEATHING         - 38mm x 140mm WOOD STUDS @ 410mm c/c         - PROVIDE HOR. STUD BLOCKING @ 1/3 SPAN         - (RSI 4.23) R24 BATTS INSULATION         - 16mm CGC TYPE 'X' AQUATOUGH GYPSUM BOARD U/N (RM 101))         - 16mm CGC TYPE 'X' GYPSUM BOARD (RMS. 102, 103, 104, 105, 106, 107)	2 1 No.	Record Information Added General Revisions Revision	GAR Ckd. By RAWINC	Nov. 2011 7-June-2010 Date
W1				
LINE UP OUTER FACE OF SHEATHING WITH OUTER FACE OF FOUNDATION WALL BELOW.		ORIGINAL DRAWING STAMPED ON 02 July 2010 BY G. A. ROSS P. ENG.	Drawn By: Dwg. Standard Ckd. By:	STAFF
OVERLAP INSULATION UPWARD 100mm MIN. OVER TOP OF FDN. WALL AIR SPACE TOP OF CONC. WALL	Date Pri	nted 2-JULY-2010	Designed By: Dwg. Design Ckd. By: Branch Manager:	
EXTEND 25mm RIGID INSULATION (XPS) TO TOP OF FOUNDATION WALL & SECURE WITH GALV. SELF-TAPPING CONC. SCREWS C/W 2" Ø GALV. WASHERS @ 16" C/C INSECT SCREEN / MESH AT BOTTOM TOP OF CONC. FLOOR	89 Quee Truro, N	n Street	RN IATES LII and design e	MITED
OVERLAP ABM OVER 1.2mm (18 ga) (SLOPED TOP) PRE-FINISHED GALV. FLASHING TEXTURED COATING SYSTEM (SYNERGY OR EQUAL) OVER INSULATION ABOVE GRADE	Client	lunicipality of	East Ha	ants
- 0.25mm (10 MIL) POLY VAPOUR BARRIER	Project 1	ītle		
WELL COMPACTED GRANULAR BACKFILL OR UNDISTURBED NATIVE TILL MATERIAL		Shubena	acadie	

- 38mm RIGID INSULATION (XPS) EXTEND 610mm MIN BELOW GRADE

<u>NOTE:</u> FOR CONCRETE SLAB, FOUNDATION & FOOTING SIZES & REINF. SEE STRUCT. DWGS.

- SOLID BEARING

Wa	ter Treatment Plant
Drawing Title	Wall Sections
Project No.	

LH0922160


Dwg. No.

304

AS NOTED This drawing is not to be scaled

Rev. No.


2

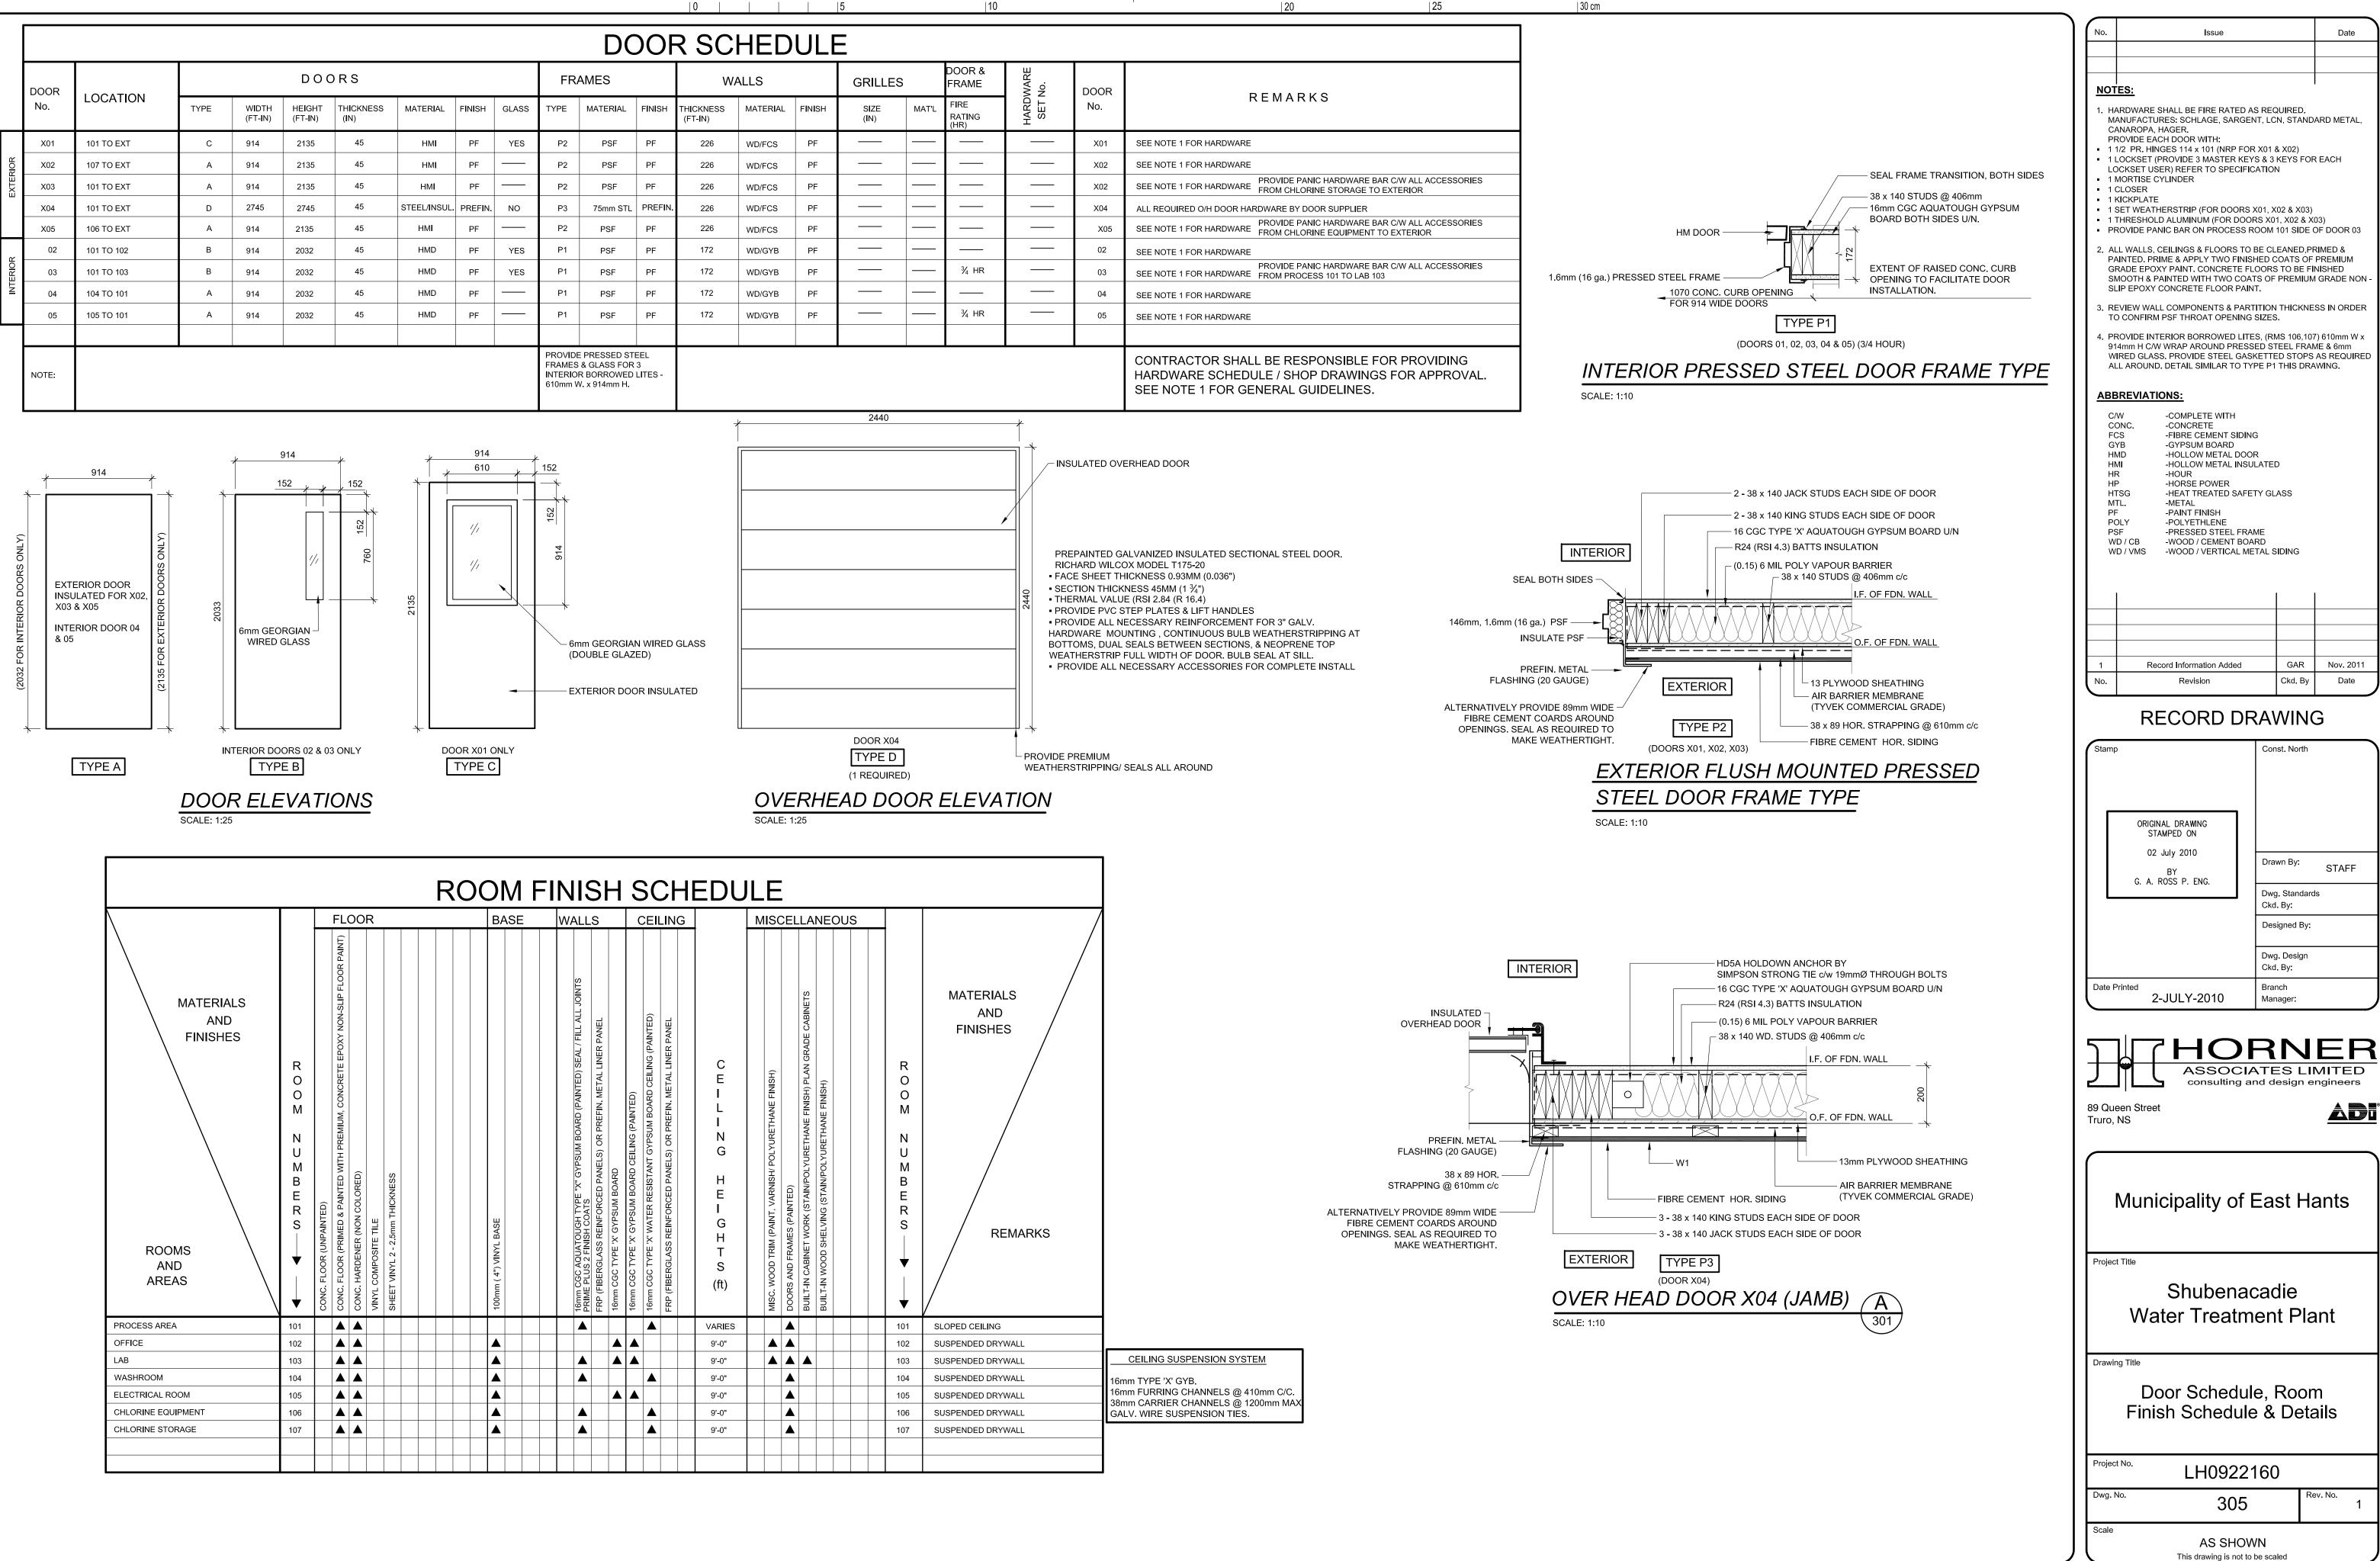

-++

-+-+



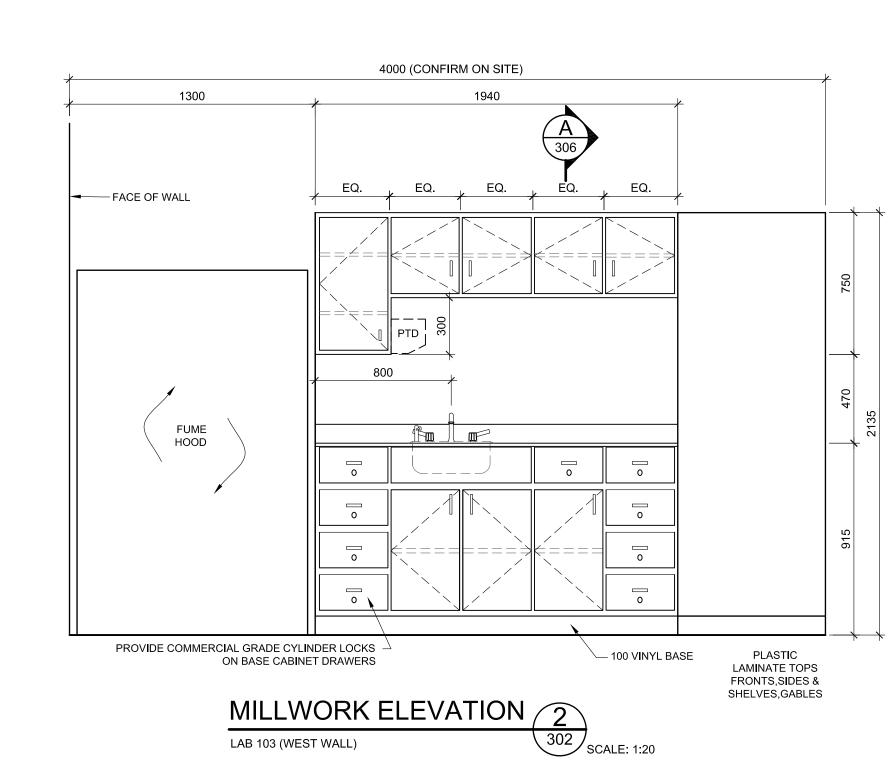

1

	4000 (CONFIRM ON SITE) 10 EQUAL DOORS/DRAWERS	
	$\begin{bmatrix} 1 \\ + & EQ. $	٦
WALLS & BASE CABINETS USE SPACER PANELS 50mm MAX) AS REQUIRED AT EAST WALL LOCATION		750
		470
		915
	PLASTIC LAMINATE TOPS	

LAMINATE TOPS FRONTS,SIDES & SHELVES,GABLES

MILLWORK ELEVATION 302 SCALE: 1:20

LAB 103 (EAST WALL)


I




20


25

| 30 cm

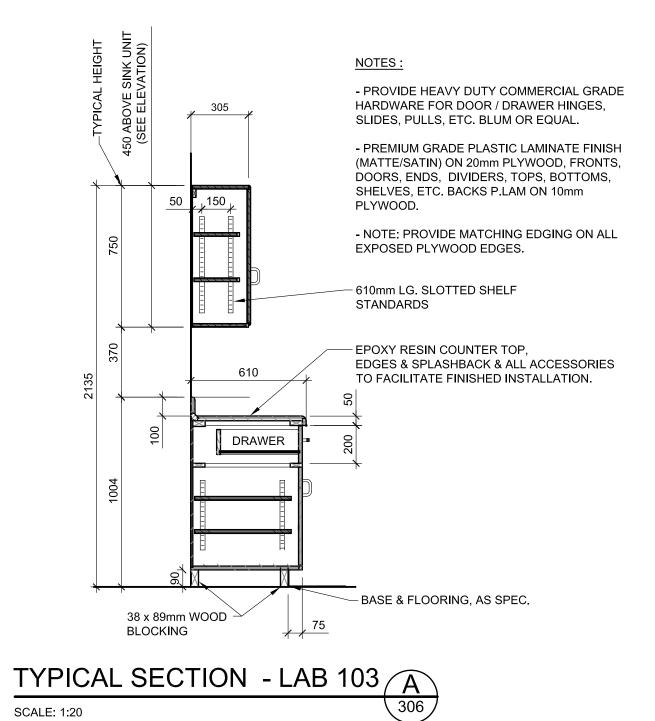

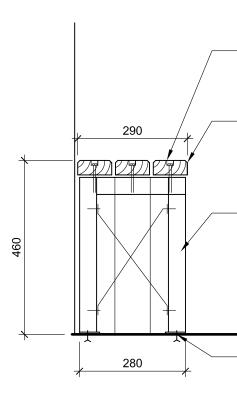




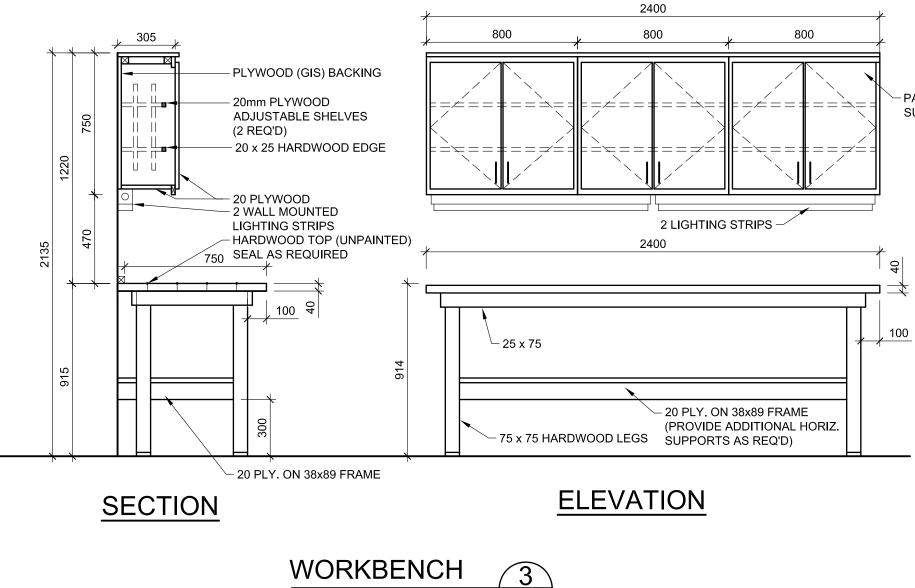


(PROCESS AREA 101)


302 SCALE: 1:20

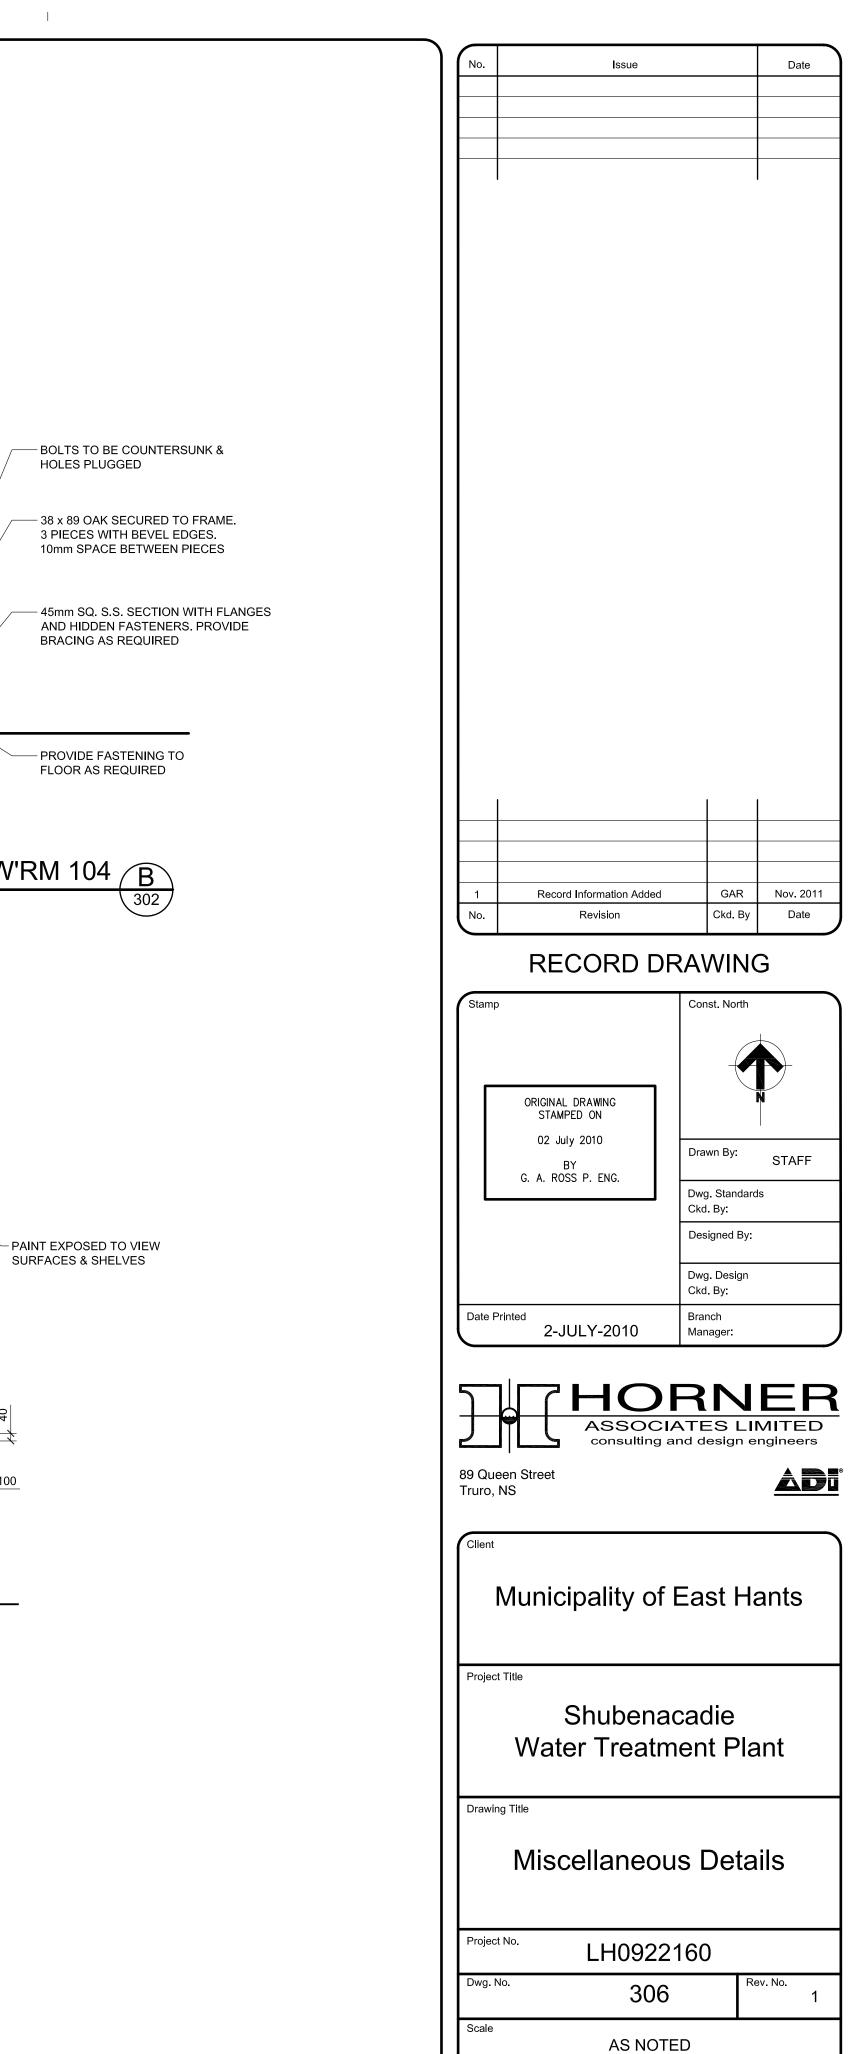


This drawing is not to be scaled

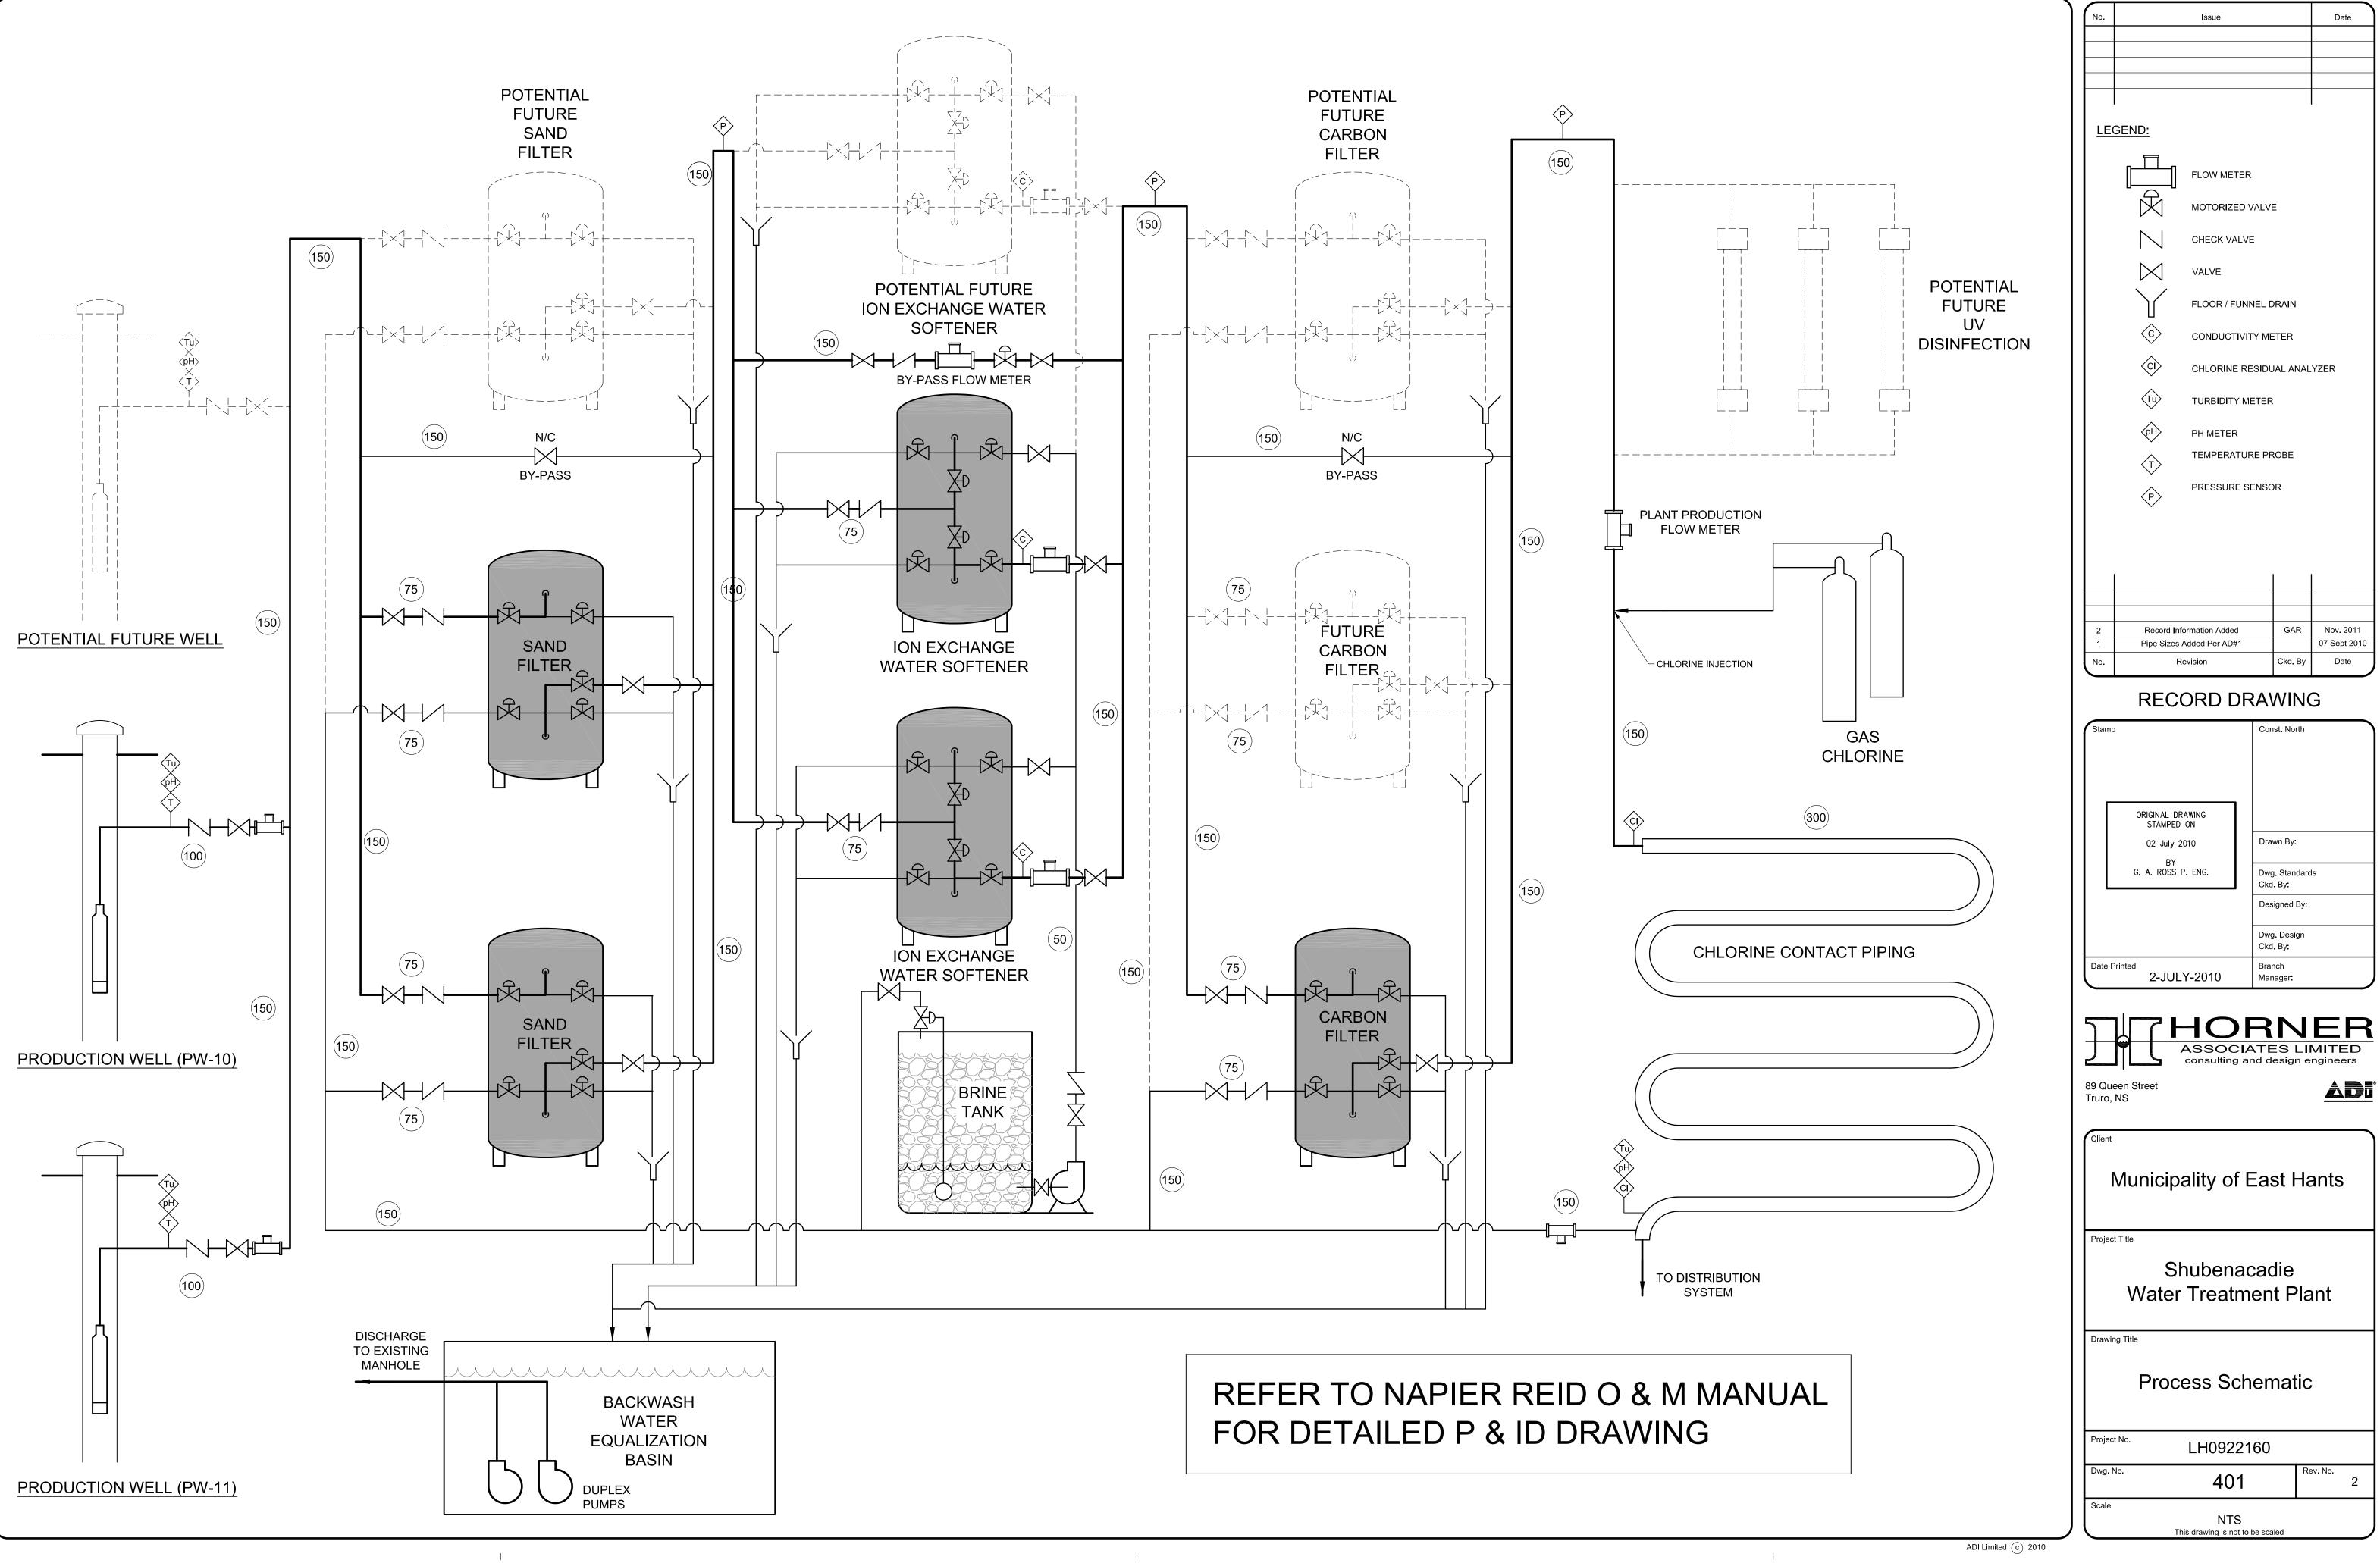

| 30 cm

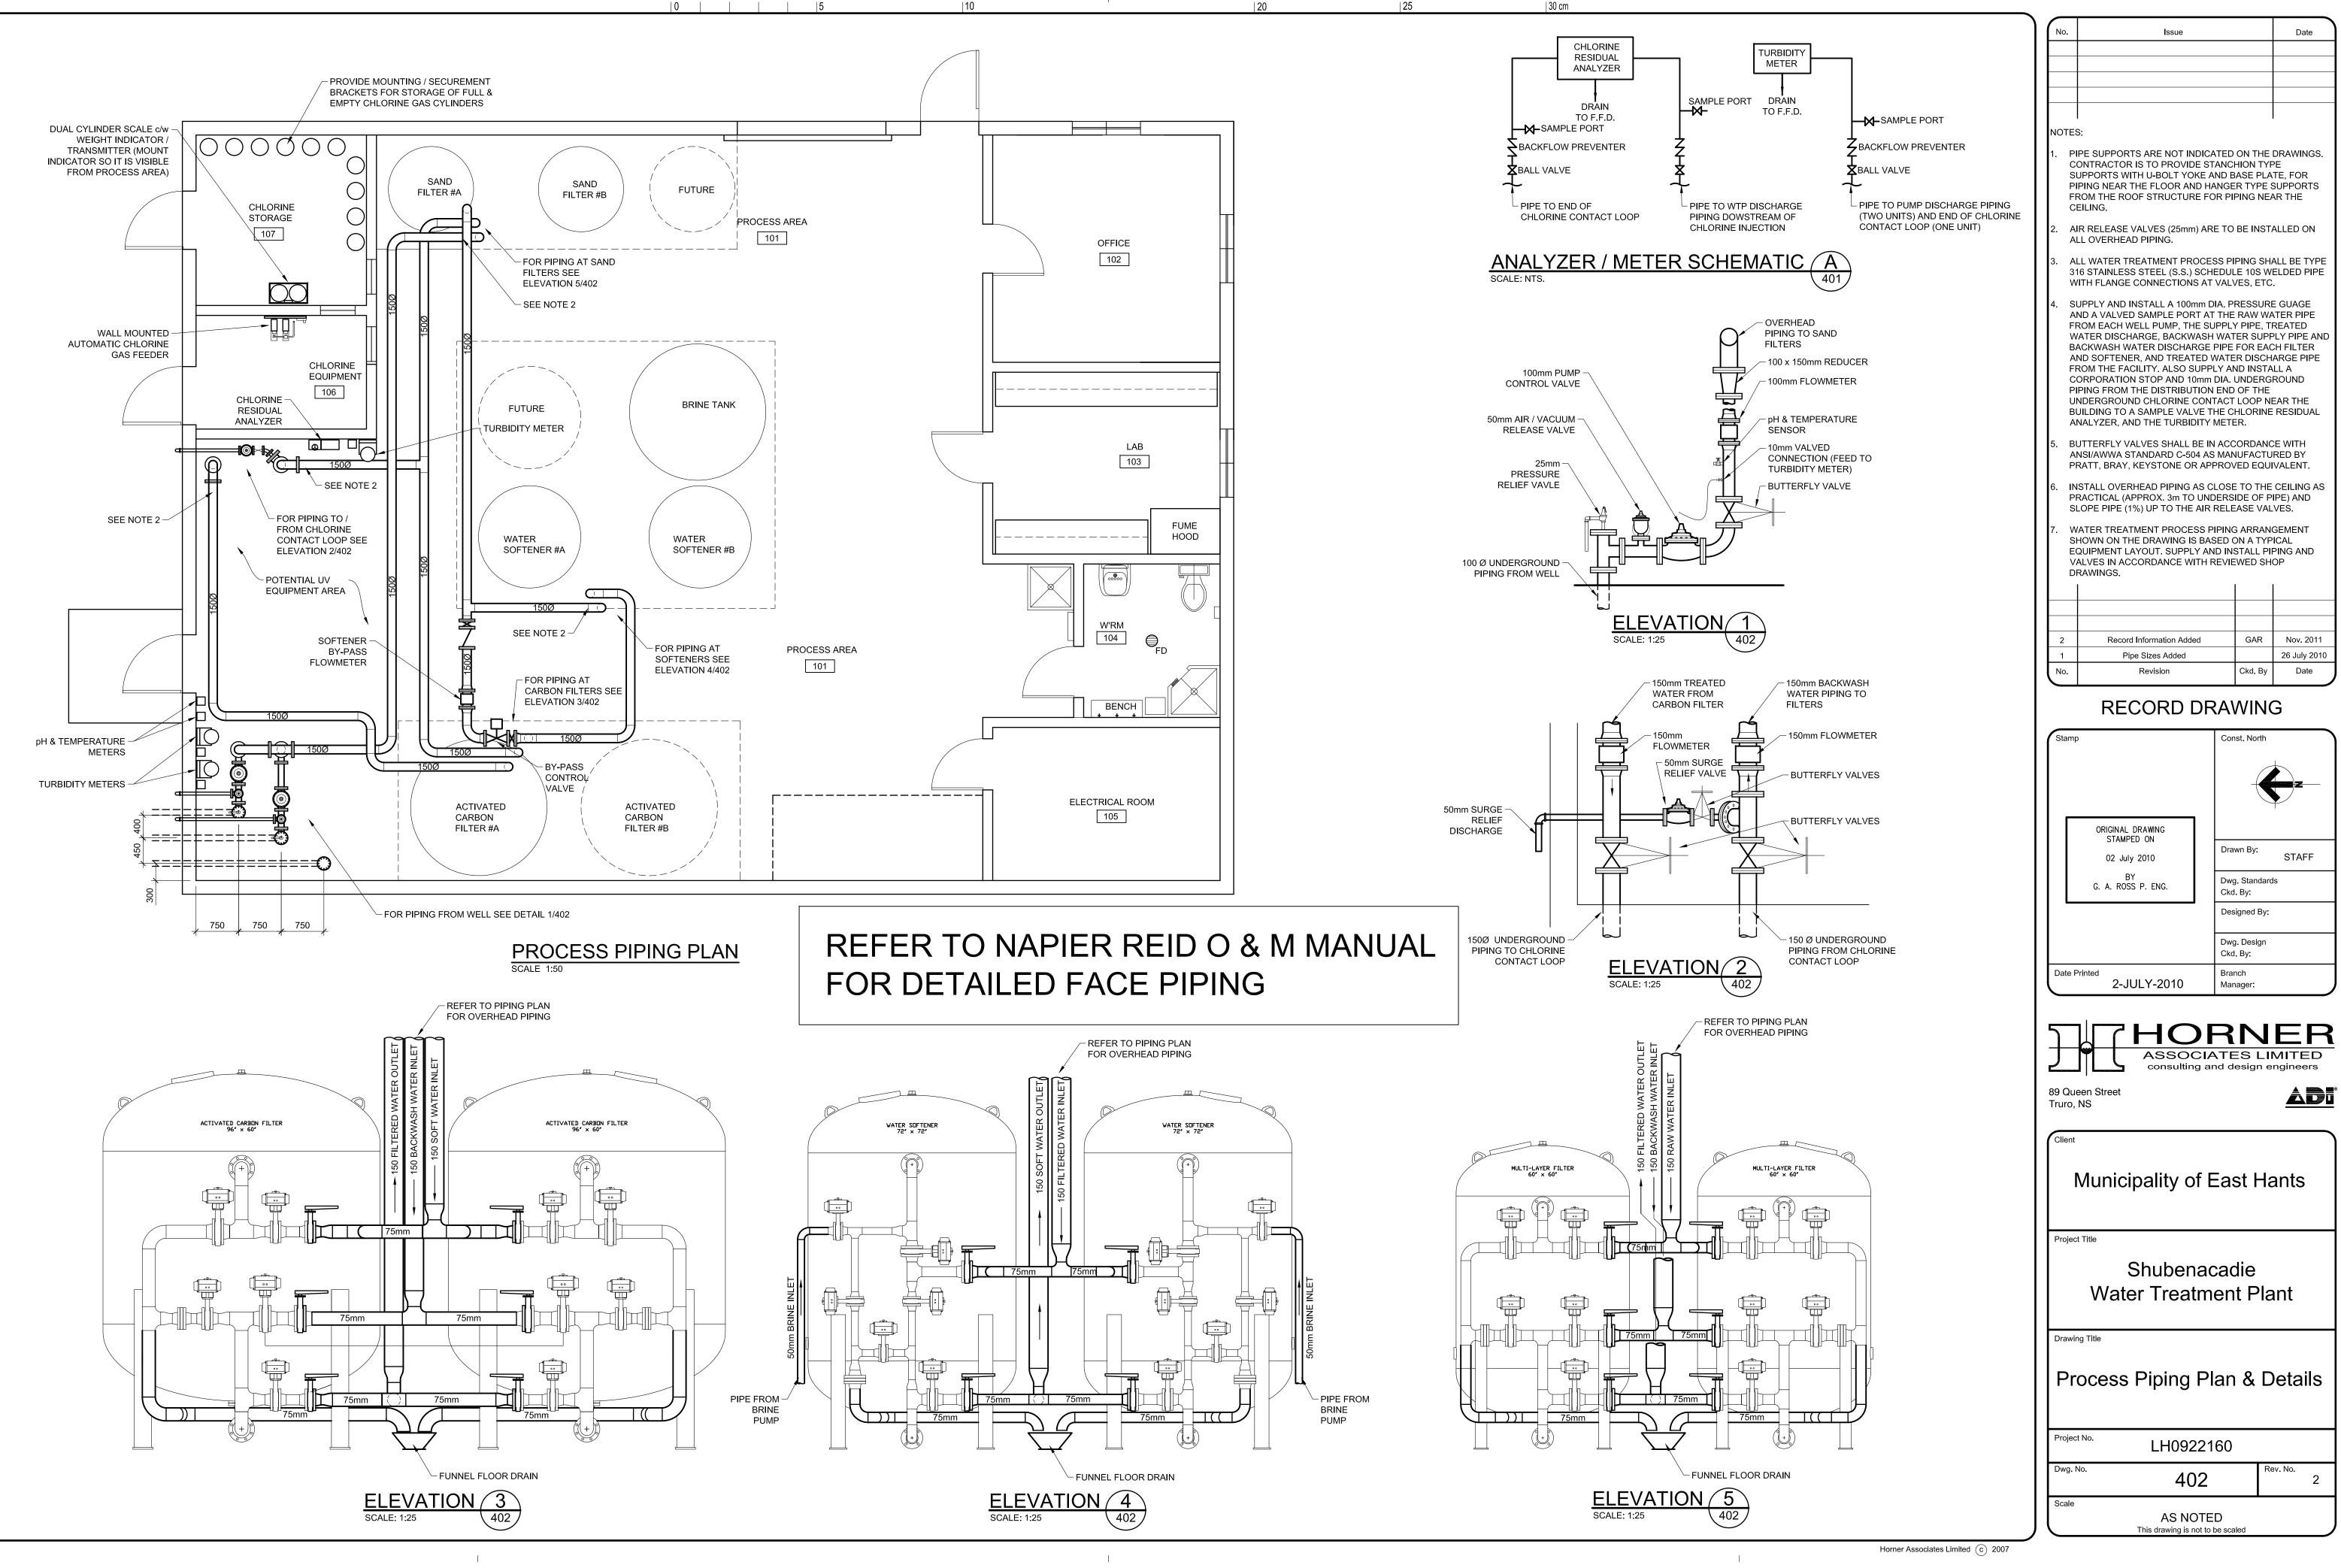



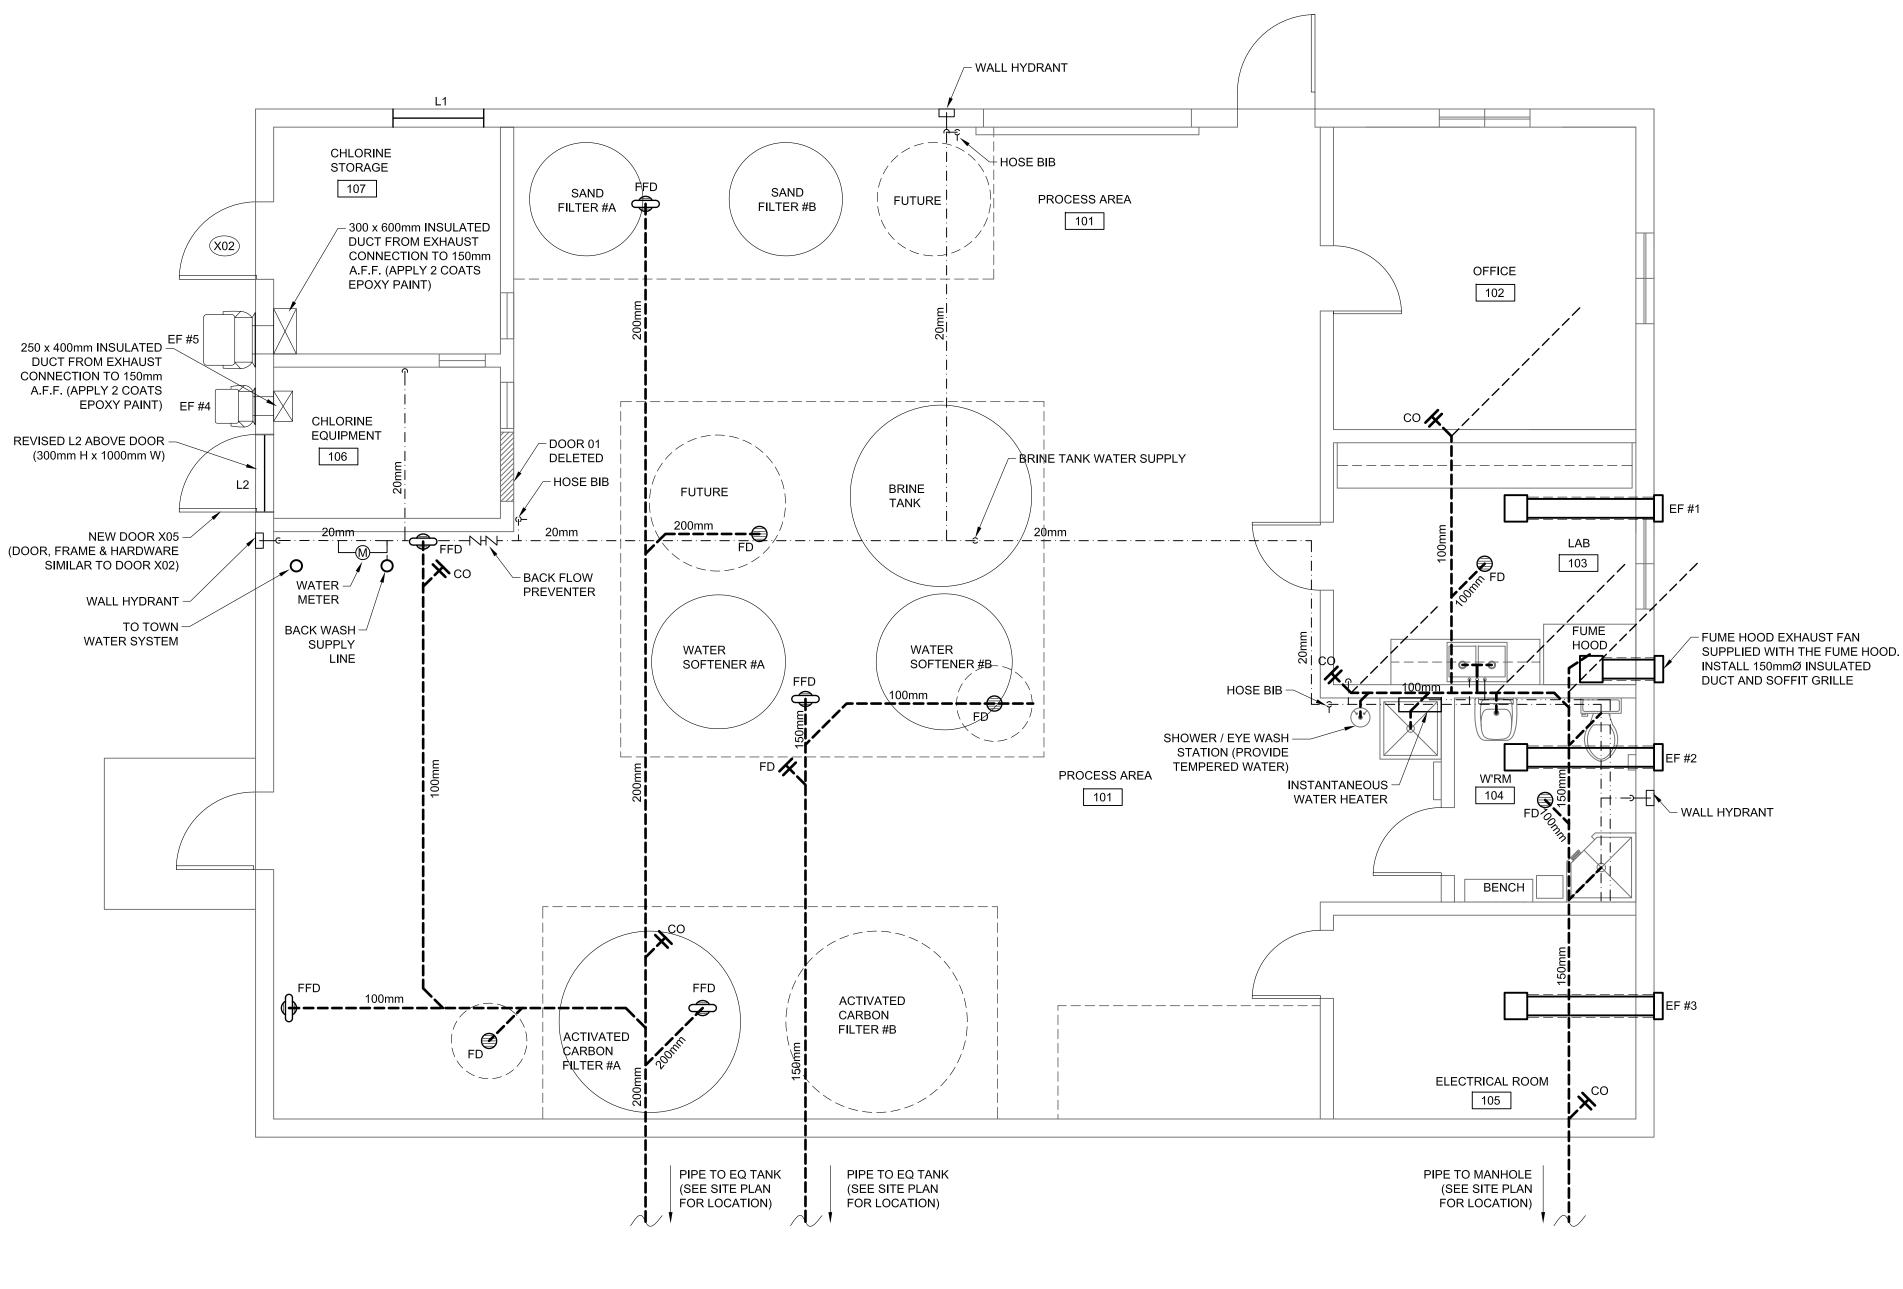

# PLUMBING & VENTILATION PLAN FLOOR PLAN

## **NOTES (VENTILATION):**

1. ALL WORK SHALL BE PERFORMED IN ACCORDANCE 6. RECTANGULAR DUCTS SHALL BE CONSTRUCTED IN WITH APPLICABLE VENTILATION BY-LAWS OF THE MUNICIPALITY IN WHICH THE BUILDING IS LOCATED, & STANDING DRIVE SLIP CONNECTIONS. ALL JOINTS THE REQUIREMENTS OF THE NBC (LATEST REVISION), THE ASHRAE GUIDE, DATA AND HANDBOOKS (LATEST REVISION), & THE CANADIAN PLUMBING CODE (LATEST **REVISION**).

2. ALL DUCTWORK AND OTHER EQUIPMENT SHALL BE INSULATED WITH ONE INCH THICK FIBERGLASS INSTALLED WITH STRUCTURAL SUPPORTS, HANGERS & BRACES TO FIRMLY ANCHOR & SUPPORT THE EQUIPMENT. MAXIMUM SPACING OF DUCT HANGERS TO BE 2.4m O.C. DIFFUSERS AND GRILLES TO BE SUPPORTED FROM THE DUCTWORK.

3. ALL EQUIPMENT & MATERIALS SHALL BE INSTALLED IN A MANNER TO LIMIT NOISE LEVEL. FLEXIBLE DUCT CONNECTIONS SHALL BE USED TO ISOLATE THE DUCT WORK FROM THE VENTILATION UNIT.

4. ALL DUCTS SHALL BE GALVANIZED STEEL. (24 GAUGE - LESS THAN 350mmØ; 22 GAUGE - LESS THAN 660mmØ; 20 GAUGE - LESS THAN 900mmØ)

5. ALL BENDS, ELBOWS & JOINTS SHALL BE CONSTRUCTED IN A NEAT WORKMANLIKE MANNER BY QUALIFIED SKILLED SHEET METAL WORKERS. SQUARE RECOMMENDED MAINTENANCE SCHEDULE AND BENDS SHALL BE MADE WITH APPROVED TURNING VANES INSTALLED IN THE BENDS. THE INSIDE RADIUS OF ELBOWS IN DUCTS SHALL NOT BE LESS THAN THE WIDTH OF THE DUCT IN THE PLANE OF THE TURN. GREAT CARE SHALL BE EXERCISED TO AVOID SHARP PROJECTIONS OR SUDDEN CHANGES IN DIRECTION OF DUCTS OR MISALIGNMENTS AT FLEXIBLE COUPLINGS.

SECTIONS WITH LOCK-SEAMS & JOINED WITH MUST BE MECHANICALLY RIGID, TAPED FOR TIGHTNESS USING AN APPROVED TAPE CONFIRMING

7. ALL INTAKE AND EXHAUST AIR DUCTS SHALL BE INSULATION WITH VAPOUR BARRIER.

TO ULC-S109-1969.

8. EXACT LOCATION OF DIFFUSERS AND GRILLES TO BE CO-ORDINATED WITH LIGHTING PLAN.

9. INSTALLATION OF DUCTWORK AND EQUIPMENT SHALL BE COORDINATED WITH THE BUILDING CONTRACTOR. PROVIDE BUILDING CONTRACTOR WITH EQUIPMENT DIMENSION AND MINIMUM REQUIRED CLEARANCES TO ALLOW FOR APPROPRIATE CONSTRUCTION OF BUILDING STRUCTURE AND EQUIPMENT ACCESS.

10. SUPPLY THREE (3) OPERATIONS AND MAINTENANCE MANUALS INCLUDING EQUIPMENT DESCRIPTIONS, OPERATING INSTRUCTIONS, AS BUILT DRAWINGS, TROUBLE SHOOTING TECHNIQUES, A RECOMMENDED LUBRICANTS.

# **EXHAUST FAN SYSTEMS:**

- 1. EXHAUST FAN (E.F. #1, E.F. #2, E.F. #3,) COOK MODEL GEMINI, GN 220 @ 1050 RPM C/W 8" x 8" GRILLE (NAILER MODEL 61EC), 150mm x 300mm DUCT TO FAN, 150mmØ INSULATED DUCT TO ALUMINUM SOFFIT GRILLE. WIRE EXHAUST FANS TO SEPARATE WALL MOUNTED SWITCHES. PROVIDE REVERSE ACTING THERMOSTAT FOR E.F.#3.
- 2. EXHAUST FAN (EF #5) COOK MODEL ACW-B 120 W2B @ 1110 RPM; RATED 427 L/S @ 93 PA c/w WALL HOUSING, BIRD SCREEN, DISCONNECT SWITCH, AND REVERSE ACTING THERMOSTAT. WIRE CONTROLS TO MOTORIZED DAMPER (L1). ALLOW FOR DUCTWORK CONNECTION.
- 3. EXHAUST FAN (EF #4) COOK MODEL ACW-B 100 W2B @ 1165 RPM; RATED 148 L/S @ 93 PA c/w WALL HOUSING, BIRD SCREEN, DISCONNECT SWITCH, AND REVERSE ACTING THERMOSTAT. WIRE CONTROLS TO MOTORIZED DAMPER (L2). ALLOW FOR DUCTWORK CONNECTION.











| 30 cm

- WATER PIPING.
- AT TOILETS AND LAVS).
- CONTRACTOR.
- COMPACTED TO 100% PROCTOR.

- PLANS.
- RECOMMENDED LUBRICANTS.

## LAVATORY (RM104)

IANITOR SINK (RM 101) Truro, NS

## LAB SINK (RM 103) :

THE BUILDING AREAS. BACKFILL SHALL BE TYPE 2 GRAVEL AMERICAN STANDARD CHAMPION ELONGATED TOILET 5/ BOLT CAPS, SHOWER (RM 104) :

TECHNIQUES, A RECOMMENDED MAINTENANCE SCHEDULE AND **PLUMBING FIXTURES:** AMERICAN STANDARD MODEL LOW VOLUME FLUSH FIT AQUALYN WATER CLOSET (RM 104) : NON-FREEZING WALL HYDRANT (THREE): TRAP SEAL PRIMER (RM 103 & 104) : WATER HEATER (RM 101) :

NOTES: 1. ALL PLUMBING WORK TO BE IN ACCORDANCE WITH THE NATIONAL BUILDING CODE, CANADIAN PLUMBING CODE AND LOCAL PLUMBING BY-LAWS. 2. DRAINAGE AND VENT PIPING AND FITTINGS SHALL BE PVC-DWV CONFORMING TO CSA STANDARD B181.2. DOMESTIC WATER PIPING AND FITTINGS ABOVE FLOOR SHALL BE TYPE "L" COPPER CONFORMING TO CSA STANDARD HC7.5. DOMESTIC WATER PIPING BELOW GROUND TO BE HDPE PIPE. 3. SUPPLY AND INSTALL 13mm INSULATION ON ALL DOMESTIC HOT 4. INSTALL PIPES STRAIGHT, PARALLEL AND CLOSE TO WALLS AND CEILINGS. PIPING IN FINISHED ROOMS TO BE CONCEALED (EXCEPT 5. SUPPLY AND INSTALL VENT PIPING FROM ALL FIXTURES TO A SINGLE VENT THROUGH THE ROOF LOCATED NEAR ROOM 104. INCLUDE PREFORMED VENT PIPE FLASHING AND DUAL WALL VENT PIPE COVER TO SUIT ROOFING. COORDINATE WITH ROOFING 6. THE WORK IS TO INCLUDE EXCAVATION, BEDDING AND BACKFILL (INCLUDING COMPACTION) FOR ALL UNDERFLOOR PLUMBING IN 7. COORDINATE THE WORK OF THIS CONTRACT WITH THE CONCRETE CONTRACTOR AND THE BUILDING CONTRACTOR. 8. WHERE POSSIBLE, THERE SHALL BE NO EXPOSED TO VIEW PIPING. 9. ALL UNDER SLAB PIPING AND VERTICAL PIPING RISER LOCATIONS IN FINISHED AREAS TO BE LOCATED IN CONJUNCTION WITH PARTITION LOCATIONS, CO-ORDINATE WATER CLOSET DRAINAGE **OPENINGS & FLOOR DRAINS, ETC. WITH DIMENSIONED PARTITION** 10. WHERE POSSIBLE, INSTALL CLEANOUTS CONCEALED IN THE WALLS WITH ACCESS HATCHES. CO-ORDINATE LOCATIONS WITH BUILDING DETAILS. WHERE FLOOR MOUNTED CLEANOUTS ARE REQUIRED THEY SHALL BE INSTALLED FLUSH WITH THE FINISHED FLOOR. 11. SUPPLY THREE (3) OPERATIONS AND MAINTENANCE MANUALS INCLUDING EQUIPMENT DESCRIPTIONS, OPERATING INSTRUCTIONS, AS BUILT DRAWINGS, TROUBLE SHOOTING COUNTERTOP SINK WITH 100mm FAUCET HOLE PUNCH & EXTRA RIGHT HAND SOAP DISPENSER HOLE c/w MONTERREY TWO-HANDLE (100mm BLADE) CENTRE SET SINK FAUCET WITH CONVENTIONAL SPOUT, SUPPLIES WITH STOPS AND ESCUTCHEONS, TAIL PIECE AND ESCUTCHEON. KINDRED INDUSTRIES, STEEL QUEEN MODEL QDL-2 c/w, MONTERRAY FAUCET GL-7500.1700, TRAP (WITH CLEANOUT), ANGLE SUPPLIES (WITH STOPS) AND ESCUTCHEONS. OPEN FRONT SEAT, SOLID PLASTIC LID AND ANGLE SUPPLY (WITH STOP AND ESCUTCHEON), AND BOLTED DOWN TANK COVER. FIAT MODEL TSB 3001 BASIN c/w 830-AA SERVICE SINK FITTINGS, 832-AA HOSE AND WALL HOOK, 889-CC MOP HANGER, 1239 BB BUMPER GUARD AND MSG 3232 STAINLESS STEEL WALL GUARDS. FLOOR DRAINS (RMS 101, 103, & 104) : ZURN MODEL ZN-415-B-P, CAST IRON BODY, ADJUSTABLE HEAD, NICKEL BRONZE STRAINER, INTEGRAL SEEPAGE PAN, CLAMPING COLLAR AND TRAP SEAL PRIMER CONNECTION. FLOOR DRAIN PIPE SIZE AS INDICATED. SUPPLY FUNNEL GRATES WHERE INDICATED (OVERSIZE FUNNELS AT SAND FILTERS, SOFTENERS & CARBON FILTERS). ZURN MODEL 1300-VB C/W INTEGRAL VACUUM BREAKER, NPS 3/4 HOSE OUTLET AND REMOVABLE OPERATING KEY. INCLUDE SHUT OFF VALVE ON WATER SUPPLY. HOSE BIBS (RM 101): HOSE BIB SHALL CONSIST OF 13mm REGULAR HANDLE FAUCET WITH BACKFLOW PREVENTER. (PROVIDE ONE HOSE RACK AND 7.6m OF HOSE IN EACH ROOM). EMERGENCY SHOWER / EYEWASH (RM 103) : HAWS MODEL 8300 c/w WATER TEMPERING CONTROL VALVE. CONNECT EYEWASH BASIN TO DRAIN. PRECISION PLUMBING PRODUCTS MODEL P-2 TRAP PRIMER. PROVIDE TRAP SEAL PRIMING PIPE FOR THE FLOOR DRAINS IN RMS 103 AND 104 PLUS THE SHOWER IN RM 104. STIEBEL ELTRON MODEL 36 PLUS INSTANTANEOUS WATER HEATER. FIAT MODEL S86 COMMANDER, STAINLESS STEEL INSIDE AND OUTSIDE c/w BRASS CHROMIUM PLATED BRACKETS, CURTAIN ROD, CURTAIN, SOAP DISH, TERRAZZO SHOWER FLOOR, DRAIN CONNECTION, WASTE TRAP, SINGLE HANDLE PRESSURE BALANCING VALVE, SHOWER HEAD & COVER PLATES.

# LOUVERS


- L1 VENTEX MODEL 2590 (900mm H x 1200mm W) c/w INSECT SCREEN AND MOTORIZED DAMPER (WIRED TO EXHAUST FAN). MOUNTING HEIGHT IS 1.4m A.F.F.
- L2 VENTEX MODEL 2590 (300mm H x 1000mm W) c/w INSECT SCREEN & MOTORIZED DAMPERS (WIRED TO EXHAUST FAN). MOUNTING HEIGHT IS ABOVE DOOR.

No.	Iss	ue			Date
	LEGEND:				
		LEAN OU	Т		
	v				
	FD F	LOOR DR	AIN		
	TRAP PRIMER SUPPLY				
	, D	OMESTIC	: но <sup>-</sup>	T WATER	SUPPLY
	DOMESTIC COLD WATER SUPPLY				
1	Record Information	Added		GAR	Nov. 2011
No.	Revision			Ckd. By	Date
	RECORI	D DR	۲A۱	<b>NIN</b>	G
Stamp				ist. North	
				_	
Ιг	ORIGINAL DRAWING STAMPED ON				
	02 July 2010		Dra	wn By:	
BY G. A. ROSS P. ENG.					STAFF
				9. Standard . By:	IS
			Des	igned By:	
				g. Design . By:	
Date F	rinted 2-JULY-201	0	Brai		
$\overline{}$		~	widi		
	штно			NI	FP



Client						
Municipality of East Hants						
Project Title						
	ubenaca Treatmer		Plant			
Drawing Title						
Plumbi	ing & Ver	ntila	ition			
Project No.	LH0922160	)				
Dwg. No.	403		Rev. No.	1		



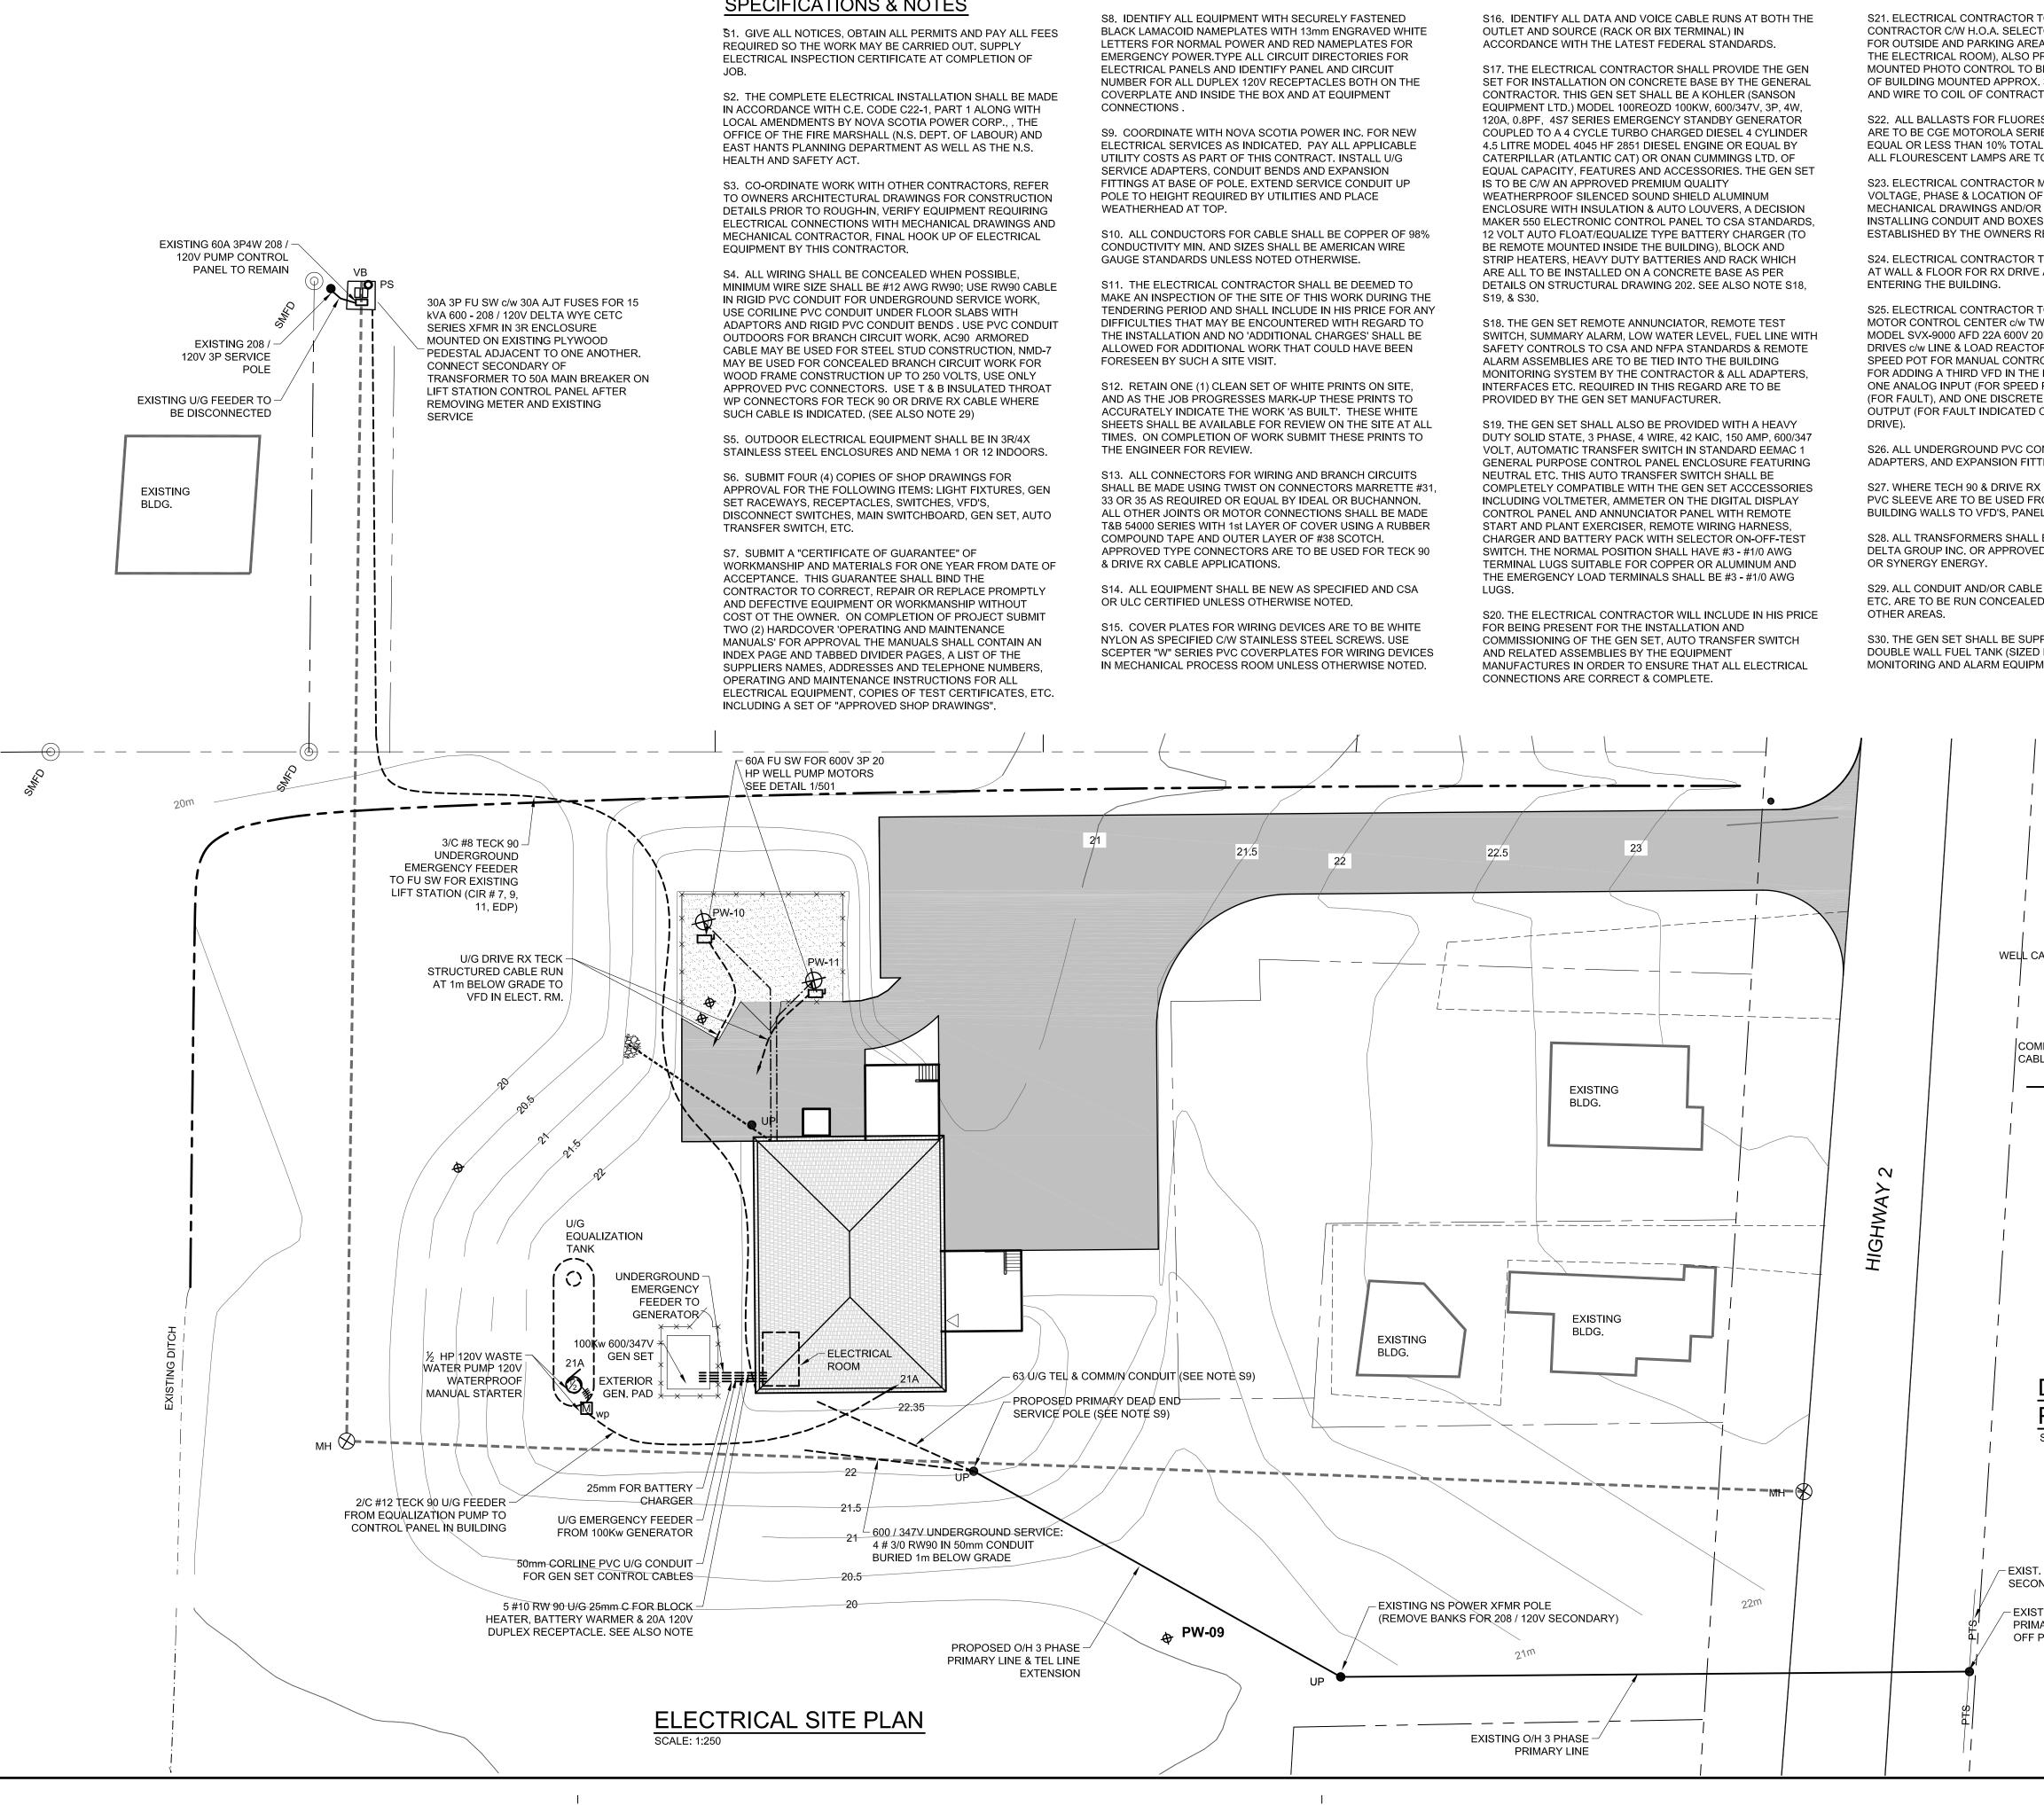


—

5	10		20	25	30	cm	
ND PAY ALL FEES T. SUPPLY IPLETION OF	BLACK LAMACOID NAMEPLAT LETTERS FOR NORMAL POW EMERGENCY POWER TYPE A ELECTRICAL PANELS AND ID NUMBER FOR ALL DUPLEX 12	OV RECEPTACLES BOTH ON THE	OUTLET AND SOUR ACCORDANCE WIT S17. THE ELECTRIC SET FOR INSTALLA	DATA AND VOICE CABLE RUNS A RCE (RACK OR BIX TERMINAL) IN H THE LATEST FEDERAL STANDA CAL CONTRACTOR SHALL PROVID TION ON CONCRETE BASE BY TH	RDS. DE THE GEN E GENERAL	S21. ELECTRICAL CONTRACTO CONTRACTOR C/W H.O.A. SELI FOR OUTSIDE AND PARKING A THE ELECTRICAL ROOM), ALSO MOUNTED PHOTO CONTROL T OF BUILDING MOUNTED APPRO	ECT REA O PF O BI OX.
N SHALL BE MADE 1 ALONG WITH 2 CORP., , THE 1 LABOUR) AND		A SCOTIA POWER INC. FOR NEW DICATED. PAY ALL APPLICABLE	EQUIPMENT LTD.) M 120A, 0.8PF, 4S7 SI COUPLED TO A 4 C	S GEN SET SHALL BE A KOHLER ( MODEL 100REOZD 100KW, 600/347 ERIES EMERGENCY STANDBY GE YCLE TURBO CHARGED DIESEL 4 045 HF 2851 DIESEL ENGINE OR E	V, 3P, 4W, NERATOR CYLINDER	AND WIRE TO COIL OF CONTR S22. ALL BALLASTS FOR FLUC ARE TO BE CGE MOTOROLA S EQUAL OR LESS THAN 10% TO	DRES ERIE
AS THE N.S.	UTILITY COSTS AS PART OF 1 SERVICE ADAPTERS, CONDU	HIS CONTRACT. INSTALL U/G	CATERPILLAR (ATL	ANTIC CAT) OR ONAN CUMMINGS FEATURES AND ACCESSORIES. T	LTD OF	ALL FLOURESCENT LAMPS AR	
ACTORS, REFER CONSTRUCTION ENT REQUIRING DRAWINGS AND	FITTINGS AT BASE OF POLE. POLE TO HEIGHT REQUIRED WEATHERHEAD AT TOP.	EXTEND SERVICE CONDUIT UP BY UTILITIES AND PLACE	IS TO BE C/W AN AF WEATHERPROOF S ENCLOSURE WITH MAKER 550 ELECTE	PPROVED PREMIUM QUALITY GILENCED SOUND SHIELD ALUMIN INSULATION & AUTO LOUVERS, A RONIC CONTROL PANEL TO CSA S	IUM . DECISION STANDARDS,	S23. ELECTRICAL CONTRACTO VOLTAGE, PHASE & LOCATION MECHANICAL DRAWINGS AND INSTALLING CONDUIT AND BO	I OF /OR XES
F ELECTRICAL POSSIBLE,	CONDUCTIVITY MIN. AND SIZ GAUGE STANDARDS UNLESS		BE REMOTE MOUN STRIP HEATERS, H	AT/EQUALIZE TYPE BATTERY CHA TED INSIDE THE BUILDING), BLOC EAVY DUTY BATTERIES AND RAC TALLED ON A CONCRETE BASE A	K AND È K WHICH	ESTABLISHED BY THE OWNER S24. ELECTRICAL CONTRACTO AT WALL & FLOOR FOR RX DR	DR T
USE RW90 CABLE RVICE WORK,	MAKE AN INSPECTION OF TH	RACTOR SHALL BE DEEMED TO E SITE OF THIS WORK DURING THE	DETAILS ON STRUC S19, & S30.	CTURAL DRAWING 202. SEE ALSO	NOTE S18,	ENTERING THE BUILDING.	
ABS WITH JSE PVC CONDUIT ) ARMORED RUCTION, NMD-7 JIT WORK FOR	DIFFICULTIES THAT MAY BE I THE INSTALLATION AND NO '/	ALL INCLUDE IN HIS PRICE FOR ANY ENCOUNTERED WITH REGARD TO ADDITIONAL CHARGES' SHALL BE VORK THAT COULD HAVE BEEN /ISIT.	SWITCH, SUMMARY SAFETY CONTROLS	REMOTE ANNUNCIATOR, REMOTE ( ALARM, LOW WATER LEVEL, FUE S TO CSA AND NFPA STANDARDS (S ARE TO BE TIED INTO THE BUIL	EL LINE WITH & REMOTE	S25. ELECTRICAL CONTRACTO MOTOR CONTROL CENTER c/w MODEL SVX-9000 AFD 22A 600 <sup>v</sup> DRIVES c/w LINE & LOAD REAC SPEED POT FOR MANUAL CON	v TW V 20 CTOF
TS, USE ONLY JLATED THROAT CABLE WHERE 9)	AND AS THE JOB PROGRESS ACCURATELY INDICATE THE	SET OF WHITE PRINTS ON SITE, ES MARK-UP THESE PRINTS TO WORK 'AS BUILT'. THESE WHITE E FOR REVIEW ON THE SITE AT ALL	INTERFACES ETC. I PROVIDED BY THE	EM BY THE CONTRACTOR & ALL / REQUIRED IN THIS REGARD ARE <sup>-</sup> GEN SET MANUFACTURER.	TOBE	FOR ADDING A THIRD VFD IN T ONE ANALOG INPUT (FOR SPE (FOR FAULT), AND ONE DISCR OUTPUT (FOR FAULT INDICATE	ED F
BE IN 3R/4X DR 12 INDOORS. NGS FOR	TIMES. ON COMPLETION OF THE ENGINEER FOR REVIEW.	WORK SUBMIT THESE PRINTS TO	DUTY SOLID STATE VOLT, AUTOMATIC GENERAL PURPOS	SHALL ALSO BE PROVIDED WITH 5, 3 PHASE, 4 WIRE, 42 KAIC, 150 A TRANSFER SWITCH IN STANDARI E CONTROL PANEL ENCLOSURE S AUTO TRANSFER SWITCH SHAL	MP, 600/347 D EEMAC 1 FEATURING	DRIVE). S26. ALL UNDERGROUND PVC ADAPTERS, AND EXPANSION F	
FIXTURES, GEN D'S, GEN SET, AUTO	SHALL BE MADE USING TWIS 33 OR 35 AS REQUIRED OR E ALL OTHER JOINTS OR MOTO	T ON CONNECTORS MARRETTE #31, QUAL BY IDEAL OR BUCHANNON. IR CONNECTIONS SHALL BE MADE AYER OF COVER USING A RUBBER	COMPLETELY COM INCLUDING VOLTMI CONTROL PANEL A	PATIBLE WITH THE GEN SET ACC ETER, AMMETER ON THE DIGITAL ND ANNUNCIATOR PANEL WITH F EXERCISER, REMOTE WIRING HA	CESSORIES DISPLAY REMOTE	S27. WHERE TECH 90 & DRIVE PVC SLEEVE ARE TO BE USED BUILDING WALLS TO VFD'S, PA	FR(
)F R FROM DATE OF THE	COMPOUND TAPE AND OUTE APPROVED TYPE CONNECTO & DRIVE RX CABLE APPLICAT	RS ARE TO BE USED FOR TECK 90	CHARGER AND BAT SWITCH. THE NORM TERMINAL LUGS SI	ITERY PACK WITH SELECTOR ON MAL POSITION SHALL HAVE #3 - # JITABLE FOR COPPER OR ALUMIN LOAD TERMINALS SHALL BE #3 - #	-OFF-TEST 1/0 AWG NUM AND	S28. ALL TRANSFORMERS SHA DELTA GROUP INC. OR APPRO OR SYNERGY ENERGY.	
ACE PROMPTLY P WITHOUT OJECT SUBMIT NANCE	OR ULC CERTIFIED UNLESS (	BE NEW AS SPECIFIED AND CSA DTHERWISE NOTED. RING DEVICES ARE TO BE WHITE		CAL CONTRACTOR WILL INCLUDE	IN HIS PRICE	S29. ALL CONDUIT AND/OR CA ETC. ARE TO BE RUN CONCEA OTHER AREAS.	
L CONTAIN AN ST OF THE DNE NUMBERS, S FOR ALL RTIFICATES, ETC. NGS".	SCEPTER "W" SERIES PVC CO	AINLESS STEEL SCREWS. USE DVERPLATES FOR WIRING DEVICES DOM UNLESS OTHERWISE NOTED.	AND RELATED ASS MANUFACTURES IN	F THE GEN SET, AUTO TRANSFEF EMBLIES BY THE EQUIPMENT I ORDER TO ENSURE THAT ALL E E CORRECT & COMPLETE.		S30. THE GEN SET SHALL BE S DOUBLE WALL FUEL TANK (SIZ MONITORING AND ALARM EQU	ZED
/	(		<u>+</u>	_ [			
					1		
	21						
	21.	5 22	22.5	23			
							í I

	<u> </u>	ſ		
TO PROVIDE A 3P 40A	No.	Issue		Date
TOR SWITCH AND 120V COIL EA LIGHTING (TO BE LOCATED IN PROVIDE A P105A FLUSH				
BE LOCATED ON NORTH SIDE 3.0m ABOVE FINISHED GRADE TOR ON CIR # 1A.				
ESCENT LIGHTING FIXTURES IES ELECTRONIC TYPE OR IL HARMONIC DISTORTION & FO BE T8 SERIES.				
MUST VERIFY EXACT HP, F ALL MOTORS ON ALL R SHOP DRAWINGS BEFORE S FOR SAME AS REPRESENTATIVE ON SITE.				
REPRESENTATIVE ON SITE. TO PROVIDE CONDUIT SLEEVES E AND TECK 90 CABLES				
TO PROVIDE A 100A 600V 3P WO CELLS OF CUTTER HAMMER OHP 3 PHASE VARIABLE SPEED ORS, HOA & START STOP AND ROL ALSO PROVIDE PROVISION E FUTURE CELL. ALSO PROVIDE O POT), ONE ANALOG OUTPUT E INPUT AND ONE DISCRETE ON EACH VARIABLE SPEED				
ONDUITS ARE TO BE c/w BENDS, TINGS (AT POLE AND BUILDING).				
K CABLES ENTER THE BUILDING ROM ONE METER OUTSIDE EL OR EQUIVALENT.				
BE AS MANUFACTURED BY ED EQUAL BY HAMMOND, MIRUS,				
E IN OFFICE, LAB, WASHROOM D AND WHERE PRACTICAL IN				
PPLIED WITH A 1200 L SUBBASE D FOR 36 HR OF OPERATION) c/w MENT AS NOTED IN NOTE S18.				
	1 No.	Record Information Added Revision	GAR Ckd. By	Nov. 2011 Date
200 x 200mm 3m – LONG PRESSURE		RECORD DF	RAWING	G
	Stamp	)	Const. North	
60A 3P SS FU SWITCH c/w 30A AJT FUSES IN EEMAC 4X ENCLOSURE				
	[	ORIGINAL DRAWING STAMPED ON		Ň
		02 July 2010 BY	Drawn By:	STAFF
		BY D. J. CAMERON P. ENG.	Dwg. Standard Ckd. By:	S
			Designed By:	
			Dwg. Design Ckd. By:	
	Date P	Printed 2-JULY-2010	Branch Manager:	
	5	แกษ	RN	ER
PUMP CONTROL CABLE IN 25mm	上	ASSOCI		MITED
CABLE IN 25mm       CORLINE PVC       TO     CONDUIT BURIED       PUMP     750mm BELOW       MOTOR     GRADE	89 Que Truro,	een Street		<u>adi</u>
TECK STRUCTURED DIRVE RX CABLE (3 #6 CABLES & 3 #8	Client			
AWG GROUNDS) TO VARIABLE SPEED DRIVE ON MCC IN BUILDING		Municipality of E	East Ha	Ints
DETAIL 1/501 TYPICAL WELL			10	-
PUMP MOTOR CONNECTION SCALE: NTS	Project			
		Shubena Water Treatm		Int
. PRIMARY TEL & NDARY LINES	Drawin	Electrical Si	te Plan	
NDARY LINES TING IARY TAKE		Specifications		
IARY TAKE POLE	Project	t No. LH0922	160	
	Dwg. N			ev. No. 1
	Scale			'
		AS NOTE This drawing is not to		

1

|10

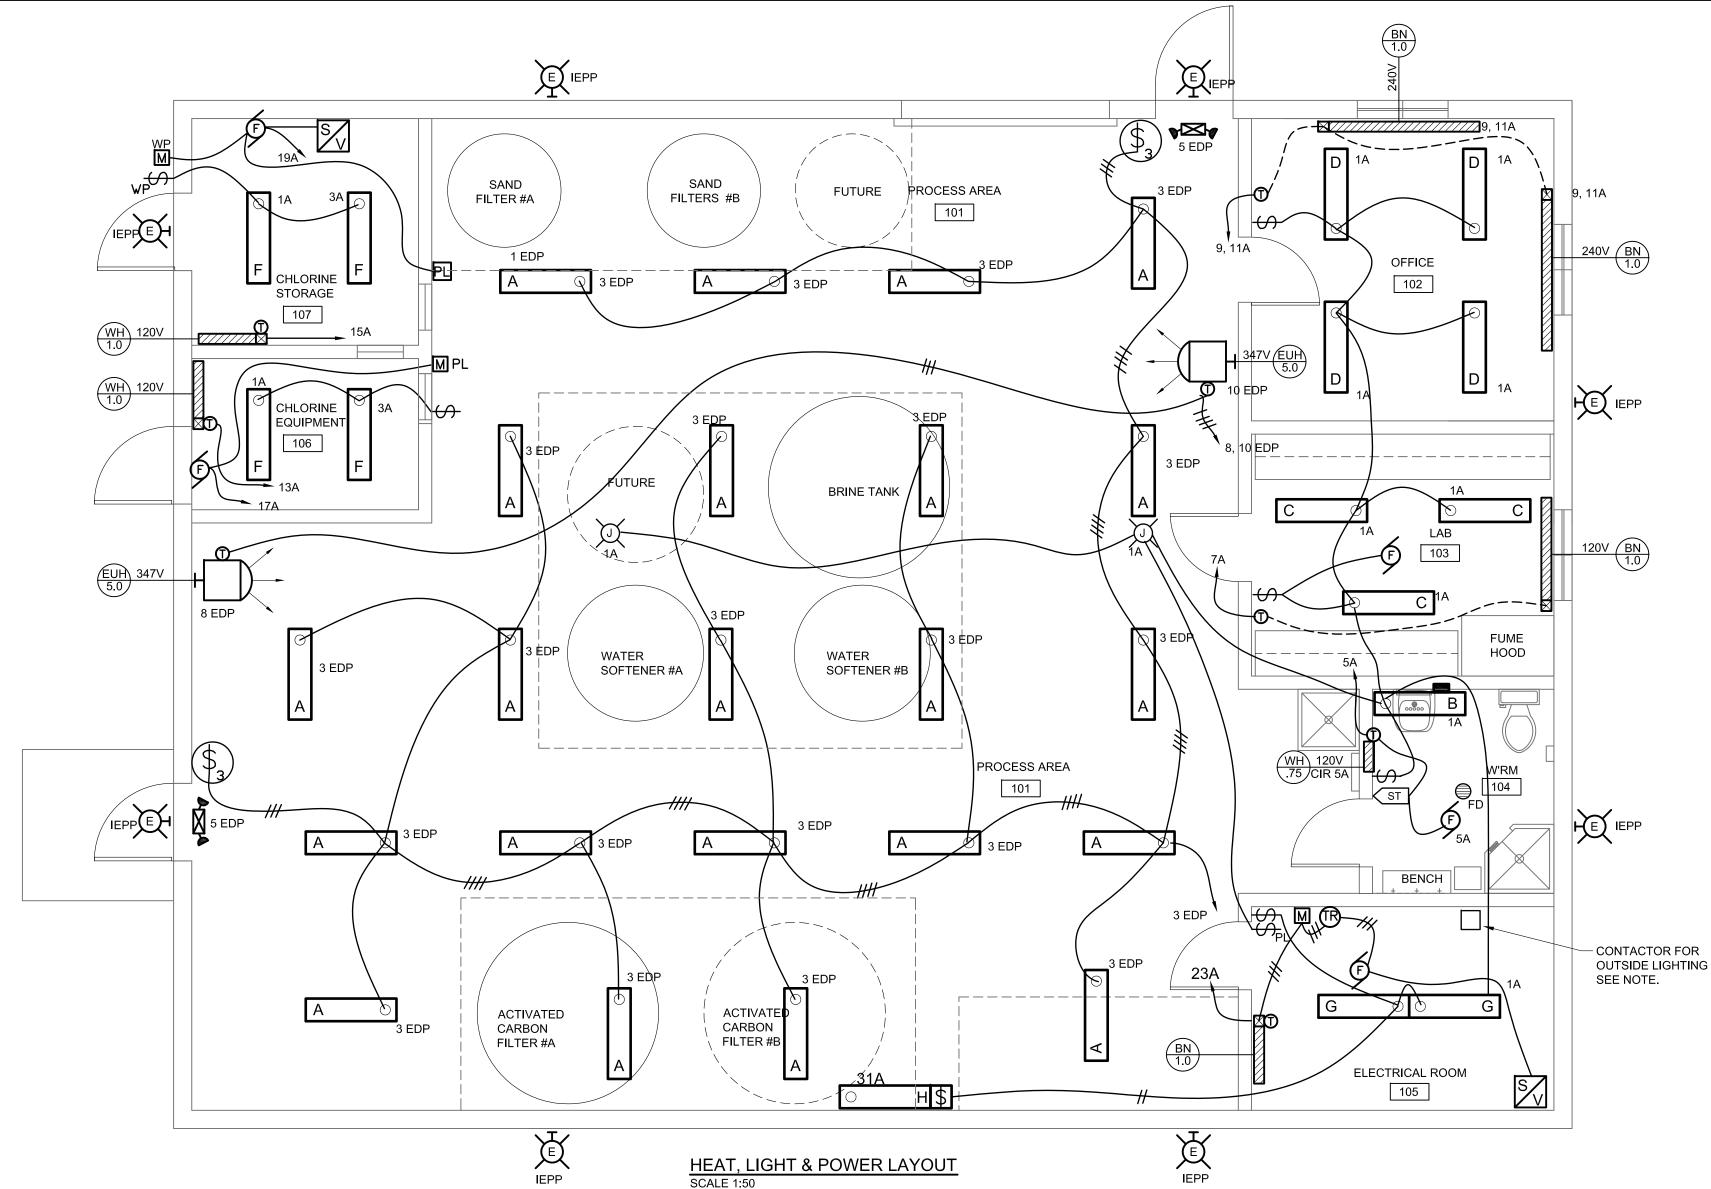

### TABLE 1/502 PANEL "A" SCHEMATIC

TABLE 1/302 FANEL A SCHEWATIC										JUZIANEL EDI											
PANEL : "A" FEEDER : SEE DETAIL 3/503		VOLTS: PHASE:	208/120V         ENTER AT:         BOTTOM           3         MAINS:         150A (60 CIR CAP)	larks		NCH CIRC D (WATTS)		larks	PANEL :	"EDP" N : Electrical Rm. 105	FEED FROM : AUTO TR			PHASE: 3	<u>–</u> <u>N</u>	MAINS:	BOTTOM 150A (60 CIR CAP)				
	BKRICIR		5W (DOUBLE NEUTRAL)	Zem Z				Rem						WIRE: 4W			SURFACE C/W TRIN		₽		
Loads Description of Equipment		3 <u>No. AM</u>		Loads		PH B	PHC		Loads	· · ·	of Equipment		.1 L2 L3	No. AMP	Des	scription of Ed	quipment	Loads	_	PH B	PHC
800 LIGHTING IN LAB OFF., WASH RM., ELECT RM.		2 15		1500	2300				-	OUTSIDE LIGHTING		15 1	┇╷╷	2 100				20000	21500		<u> </u>
300 LIGHTING IN CHLORINE STORAGE & EQUIP. ROOMS	15 3		CHLORINE STORAGE	1500		1800			1500	LIGHTING IN PROCESS AREA		15 3			DTOR CONTROL CENT	FER		20000	_	21500	<b> </b>
1000 HEATING & EXHAUST FAN IN WASH RM.			5 FUME HOOD LIGHTING & FAN	400			1400		200	EXIT LIGHTS		15 5	┼┼┿⌒	-				20000	_		20200
1000 HEATING IN LAB		~ 8 20	FUME HOOD 15A 120V RECEPTACLE	400	1400				5000			30 7	++		W HEATER IN PROCE			5000	10000	)	I
1000 HEATING IN OFFICE 2 - 1.0 kW 240V BASEBOARDS	15 9	10 15	; — 230V RECEPTACLE IN FUME HOOD IN LAB	3000		4000			5000	SEWERAGE LIFT STATION XFN c/w 30A DISCONNECT	IVIK 15KVA 600 - 2087 120 V	3P 9	┼╋┼介╴	10 2P <sup>5 k</sup>	W HEATER IN PROCE	SS RM. 101		5000		10000	ļ
	2P 11	<sup>⊥</sup> 12 2P		3000			4000		5000				┼┼┿┴	12 SP	PARE						5000
1000 HEATING IN CHLORINE EQUIP. RM. 106	15 13	14 20	SPLIT WIRED 5-20R DUPLEX 120V RECEPTACLE	1500	2500				15000			70 13	++	14 15					15000	)	
1000 HEATING IN CHLORINE STOR. RM. 107	15 15	<sup>⊥_</sup> 16 2₽	P IN LAB RM 103	1500		2500				45KVA 600 - 208 / 120 V DELTA PANEL "A"	AWYE TRANSFORMER FOR	3P 15	+++	16 3P SP	PARE 3 POLE BREAKE	R FOR FUTURE	E UV REACTOR			15000	
300 EXHAUST FAN IN CHLORINE EQUIP. RM. 106	15 17	18 20	SPLIT WIRED 5-20R DUPLEX 120V RECEPTACLE	1500			1800		15000	· ·		BKR 17	┼┼┿へ╴	18 BKR							15000
400 EXHAUST FAN IN CHLORINE STOR. RM. 107	15 19	<sup>⊥</sup> 20 2P	N LAB RM 103	1500	1900				3000			30 19	+	20 SP	ACE						
600 WASTE WATER PUMP ½ HP 120V (EQU TANK)	20 21	↑ 22 20	SPLIT WIRED 5-20R DUPLEX 120V RECEPTACLE	1500		2100				30A 600V 3 PHASE SWITCH / R FOR BATTERY CHARGER	RECEPTACLE ASSEMBLY	3P 21	┿┿╴-	22 SP	ACE						
600 HEATER & EXHAUST FAN IN ELECT. RM	20 23	⊥242P	2 IN LAB RM 103	1500			2100		3000	I STUDIATIENT OFFICIEN		BKR 23	+++ -	24 SP	ACE						
400 15A 120V RECEPTACLES IN PROCESS & ELECT. RM.	15 25	~ 26 20	SPLIT WIRED 5-20R DUPLEX 120V RECEPTACLE	1500	1900			4014										TOTAL PH	A 46500	)	
* 200 15A 120V GFCI RECEPTACLES	15 27	~28P	N LAB RM 103	1500		1700		<u>18K</u>	VAIC: UN BE	EAKERS & PANEL								TOTAL PH	в	46500	
200 15A 120V RECEPTACLES IN PROCESS AREA	15 29	30 15	3 RECEPTACLES IN OFFICE	600			800							CNO				TOTAL PH	c		40200
300 15A 120V RECEPTACLES & LIGHTING IN PROCESS AREA	15 31	32 15	2 DUPLEX RECEPTACLES IN OFFICE (SURGE PROT. & IG)	1000	1300			*	DENOTES	GFCI BKR			dddo: ABC								
300	15 33	34 15	5 15A 120V RECEPTACLES IN PROCESS RM. (NEAR OFFICE	E) 400		700												CONN. LOA		133200	
CHLORINE ANALYZER IN RM. 101	2P 35	36 15	5 15A 120V FOR TURBIDITY IN PROCESS RM.	200			500														
200 15A 120V RECEPTACLES IN PROCESS AREA	15 37	38 15	5 15A 120V FOR TURBIDITY IN PROCESS RM.	200	400																
* 3000 30A 120V CONNECTION FOR LCP - 01 (SAND FILTER)	30 39	40 15	5 15A 120V FOR TURBIDITY IN PROCESS RM.	200		3200															
* 3000 30A 120V CONNECTION FOR LCP - 02 (SOFTENER FILTER)	) 30 41	42 15	5 15A 120V FOR TURBIDITY IN PROCESS RM.	200			3200														
* 3000 30A 120V CONNECTION FOR LCP - 03 (CARBON FILTER)	30 43	44 20	) 120V 1.44 kW HOT WATER HEATER	1440	4440																
★ 400 BRIME PUMP MOTOR IN PROCESS AREA	15 45	46 20	120V 20A 5-20R RECEPTACLE IN GEN SET ENCLOSURE	1500 ★		1900	,														
750 SPARE			) 120V DIRECT CONNECTION TO 1500W BLOCK HEATER	1500			2250	) THESE B	BREAKERS	MAY BE REPLACED WITH A 50	0A										
1500 208 / 120V CONNECTION FOR SCADA CONTROL PANEL	20 49	50 15	5 120V DIRECT CONNECTION TO BATTERY CHARGER	600	2100					6 RW90 FEEDER TO AN INTEGF N GEN SET ENCLOSURE c/w	RAL										
1500 IN OFFICE			5 120V DIRECT CONNECTION TO BATTERY WARMER	100		1600				OPTIONAL)											
300			5 MONITORING PANEL IN OFFICE	200			500														
CHLORINE GAS METERING PUMP IN RM. 106	2P 55				300		·														
With the second seco		- 58	SPACE	+																	
SPARE		- 60	SPACE																		
				TOTAL PH A	10140																
10KAIC: ON BREAKERS & PANEL	$\Rightarrow \Rightarrow $	- 🔫 3P 1	150A MAIN BREAKER		18140	40500															
				TOTAL PH B		19500	40755														
	SNR口齿齿齿 A B C	₽SN1		TOTAL PH C			19750														
* DENOTES GFCI BKR	A B C		ANTICIPATED MAX DEMAND: 40KVA	CONN. LOAD		57,390															

s	PANEL :	"EDP"							VOLT		600/347V <u>ENTER AT:</u> BOTTOM		ŚŚ			
Remarks	LOCATI	ON : Electrical Rm. 105 FEED FROM : AUTO TR	ANSF	ER S	WIT	сн			PHAS WIRE		3         MAINS:         150A (60 CIR CAP)           4W         STYLE:         SURFACE C/W TRIM	AND DOOR	Remarks			
Re	Loads	Description of Equipment	BKR AMP	CIR No.		11	_2 L	3	CIR No.	BKR AMP	Description of Equipment	Loads	Å	PH A	PH B	PHC
	1500	OUTSIDE LIGHTING	15	1	$\uparrow \frown$	᠂ᡨ		-7	2	100		20000		21500		
	1500	LIGHTING IN PROCESS AREA	15	3	┣∽	-	•	-	4	3P	MOTOR CONTROL CENTER	20000			21500	
	200	EXIT LIGHTS	15	5	$\uparrow \frown$	+	$+ \bullet$	~	6	BKR		20000				20200
	5000		30	7	┠╖	ᠳ	+	$\sim$	8	20	5 kW HEATER IN PROCESS RM. 101	5000		10000		
	5000	SEWERAGE LIFT STATION XFMR 15KVA 600 - 208 / 120 V c/w 30A DISCONNECT	3P	9	ho	-	+		10	2P	5 kW HEATER IN PROCESS RM. 101	5000			10000	
	5000		BKR	11	}-⁄-	+	++	-	12		SPARE					5000
	15000		70	13	-1	┶	++	$\sim$	14	15				15000		
	15000	45KVA 600 - 208 / 120 V DELTAWYE TRANSFORMER FOR PANEL "A"	3P	15	$\uparrow \uparrow$	-	+	$\sim$	16	3P	SPARE 3 POLE BREAKER FOR FUTURE UV REACTOR				15000	
	15000		BKR	17	$\mathbb{P}^{+}$	-	$+ \bullet$	$\sim$	18	BKR						15000
	3000		30	19	-	┶	+		20		SPACE					
	3000	30A 600V 3 PHASE SWITCH / RECEPTACLE ASSEMBLY FOR BATTERY CHARGER	3P	21	}-	-	+		22		SPACE					
	3000		BKR	23	$\mathbb{P}^{+}$	\	++		24		SPACE					
1864		REAKERS & PANEL						`				TOTAL F	РΗΑ	46500		
1010						ť	<u>ן</u> ו	ナ				TOTAL F	РΗВ		46500	
				SN	J1□	Ц	┟┟		N2			TOTAL F	РΗС			40200
*	DENOTE	S GFCI BKR		0			BC					CONN. L	.OAD		133200	1

### TABLE 2/502 PANEL "EDP" SCHEMATIC

#### **HEATING & VENTILATION LEGEND** REVERSE ACTING T'STAT BY DIV 15 MECH CONTRACTOR TO BE WIRED BY TR DIV 16 ELECTRICAL CONTRACTOR TS931 / TD932 LINE VOLTAGE THERMOSTAT SUPPLIED AND INSTALLED BY $(\overline{})$ ELECTRICAL CONTRACTOR. T86A 24 VOLT THERMOSTAT BY MECHANICAL CONTRACTOR TO BE WIRED $\square$ BY ELECTRICAL CONTRACTOR BROAN MODEL P65WN0-60 MIN CONTROL AND SWITCH BY DIV 15 TO BE WIRED BY DIV 16 ON 2-GANG BOX. CHROMALOX TYPE WH 750W 120V SINGLE PHASE FAN DRIVEN WALL WH 120V .75 HEATER c/w BUILT IN T'STAT. CHROMALOX TYPE BN BASEBOARD HEATER (WITH & WITHOUT BUILT IN T'STAT. REFER TO PLAN) CHROMALOX TYPE EUH FAN DRIVEN UNIT HEATER RATED 347V 5kW SINGLE PHASE c/w BUILT IN T'STAT. 120V CONNECTION FOR EXHAUST FAN MOTOR WITH INTEGRAL OVERLOAD PROTECTION BY MECHANICAL CONTRACTOR TO BE CONNECTED TO SWITCH IN SAME ROOM OR TIMER FOR WASHROOMS, DRESSING ROOMS OR OFFICE AREA. SEE MECHANICAL DRAWINGS FOR EXACT LOCATION AND SPECIFICATION FOR FAN CONTROL. CUTLER HAMMER FLUSH MOUNTED TYPE MS MANUAL STARTER (WP Μ INDICATES c/w WP COVER PLATE SCEPTER VSC M PL

TYPE "A": STAMPRO CAT # VT-232-248-347 51" LONG SURFACE MOUNTED VAPOUR TIGHT FLUORESCENT FIXTURE c/w 2-32 WATT T8 LAMPS AND 347V ELECTRONIC BALLAST OR EQUAL BY CFI OR LITHONIA. TYPE "B": CFI CAT # CTW 248-120-SO-ZA CUBELITE SERIES 48" LONG (WHITE) FLUORESCENT FIXTURE c/w OPAL ACRYLIC LENS, 2 / 32 WATT T8 LAMPS, AND ELECTRONIC BALLAST.

TYPE "D": SAME AS ABOVE BUT WITH 2 / 32 WATT LAMPS AND ELECTRONIC BALLAST CAT # SFC-T8-232-24-A-48.

TYPE "E": KEENE RADIANCE SERIES 175W METAL HALIDE FIXTURE CAT # RD-W-175W-MA-L c/w 175 WATT E17 LAMP WIRE GUARD AND MOG LAMP BASE CONNECTED TO CONTRACTOR SUPPLIED P105 PHOTOCELL AND CONTACTOR WITH HOA SELECTOR SWITCH. FIXTURE IS TO BE MOUNTED ABOVE DOORS OR ON WALLS AT A HEIGHT OF 10' AFG OR EQUAL BY STANPRO OR LITHONIA.

TYPE "F": CFI VANDAL RESESTANT WRAP AROUND POLYCARBONANTE LENS FIXTURE 210mm WIDE CAT # VA-248-120-SO OR EQUAL BY STANPRO OR LITHONIA c/w 2/32 WATT LAMPS AND ELECTRONIC BALLAST.

TYPE "J" : LEVITON CAT.# 9800 LHG COMPACT FLUORESCENT LAMP HOLDER c/w 13W C.F. LAMP, ACRYLIC GUARD ON FLUSH MOUNTED PVC OCTAGON BOX.

(\$)

\$

 $(\$_4)$ 

(\$)

120V 15A SINGLE POLE NYLON WHITE DECORA STYLE SWITCH LEVITON CAT. No. 5691-2W C/W 80301W WHITE COVER PLATE AND SINGLE GANG BOX OR EQUAL BY HUBBELL SUFFIX WP INDICATES c/w SCEPTER VPT PLUNGER TYPE COVER PLATE.

SAME AS ABOVE EXCEPT THE SUBSCRIPT 3 OR 4 INDICATES 3 WAY CAT # 5623-2W OR 4-WAY CAT # 5624-2W SWITCH ASSEMBLY RESPECTIVELY.

LEVITON 20A BROWN 347V TOGGLE SWITCH CAT # 54521-B C/W 347V BOX & COVER PLATE OR EQUAL BY HUBBELL.

SAME AS ABOVE BUT 3 WAY 347V TOGGLE SWITCH CAT # 54523 B C/W MATCHING BOX AND COVER PLATE.

COVER PLATE.

2 GANG 347V SWITCH STATION WITH 2 GANG COVER PLATE.

### NOTES:

1. THIS DRAWING SHALL BE READ IN CONJUNCTION WITH ALL ELECTRICAL SPECIFICATION DRAWINGS, AS WELL AS ALL MECHANICAL, STRUCTURAL, AND ARCHITECTURAL DRAWINGS AND CONTRACT DOCUMENTS.

2. EQUIVALENT HEATING UNITS BY OUELETTE OR STELPRO ARE ACCEPTABLE AS EQUAL PROVIDED THEY FEATURE THE SAME CHARACTERISTICS AS THOSE SPECIFIED IN LEGEND.

25

| 30 cm

 $\left(\begin{array}{c} BN \\ 1.0 \end{array}\right)$  120

BUX 347V 5.0

ΡL

D

G

SH C

X

CUTLER HAMMER FLUSH MOUNTED TYPE MS MANUAL STARTER (WP INDICATES c/w WATERPROOF COVER, PL INDICATES c/w PILOT LIGHT

PILOT LIGHT ASSEMBLY

## LIGHTING LEGEND

TYPE "C": STELPRO CAT # SFC-T8-332-24-A-48 CELL SURFACE MOUNTED PARBOLIC SERIES 610mm WIDE FIXTURE C/w 3 - 32 WATT T8 LAMPS AND 120V 3 LAMP ELECTRONIC BALLAST OR EQUAL BY LITHONIA OR CFI CAMLYTE.

TYPE "G": 191mm WIDE x 127mm HIGH x 1220 mm LONG INDUSTRIAL FLUORESCENT FIXTURE FEATURING WHITE REFLECTOR & 2/32 WATT LAMPS AND ELECTRONIC BALLASTCAT # SB9R14-48-SO 120 FIXTURE


TYPE "H": CFI CAT # CSM41-132PF-120-SO 1210mm LONG STRIP LIGHT OR EQUAL c/w 2 T8 32 WATT LAMP ELECTRONIC BALLAST & TOGGLE SWITCH ON ONE END.

EXIT LIGHT: STAMPRO SPEXR WALL MOUNTED COMBINATION SERIES EXIT EMERGENCY LIGHT CAT # SPEXR-12-1108-2-2D-20W-Q-WM FEATURING FIBERGLASS REINFORCED PLASTIC HOUSING, 2 HEADS 72 AMP HOUR BATTERY, CHARGER, LED EXIT SIGN, ETC. OR EQUAL BY UNIGLO OR LUMACELL.

LEVITON 347V 20A TOGGLE SWITCH CAT # 54524B B C/W MATCHING BOX AND

No.	Issue		Date
I		I	
1 No.	Record Information Added Revision	GAR Ckd. By	Nov. 2011 Date

## RECORD DRAWING

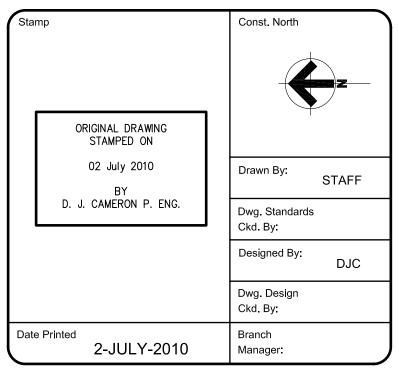



Truro, NS

Client

## Municipality of East Hants

Project Title

## Shubenacadie Water Treatment Plant

Drawing Title

Project No.

Dwg. No.


### Lighting and Heating Layout, Legend & Panel Schedules

LH0922160


Rev. No. 502

AS NOTED This drawing is not to be scaled



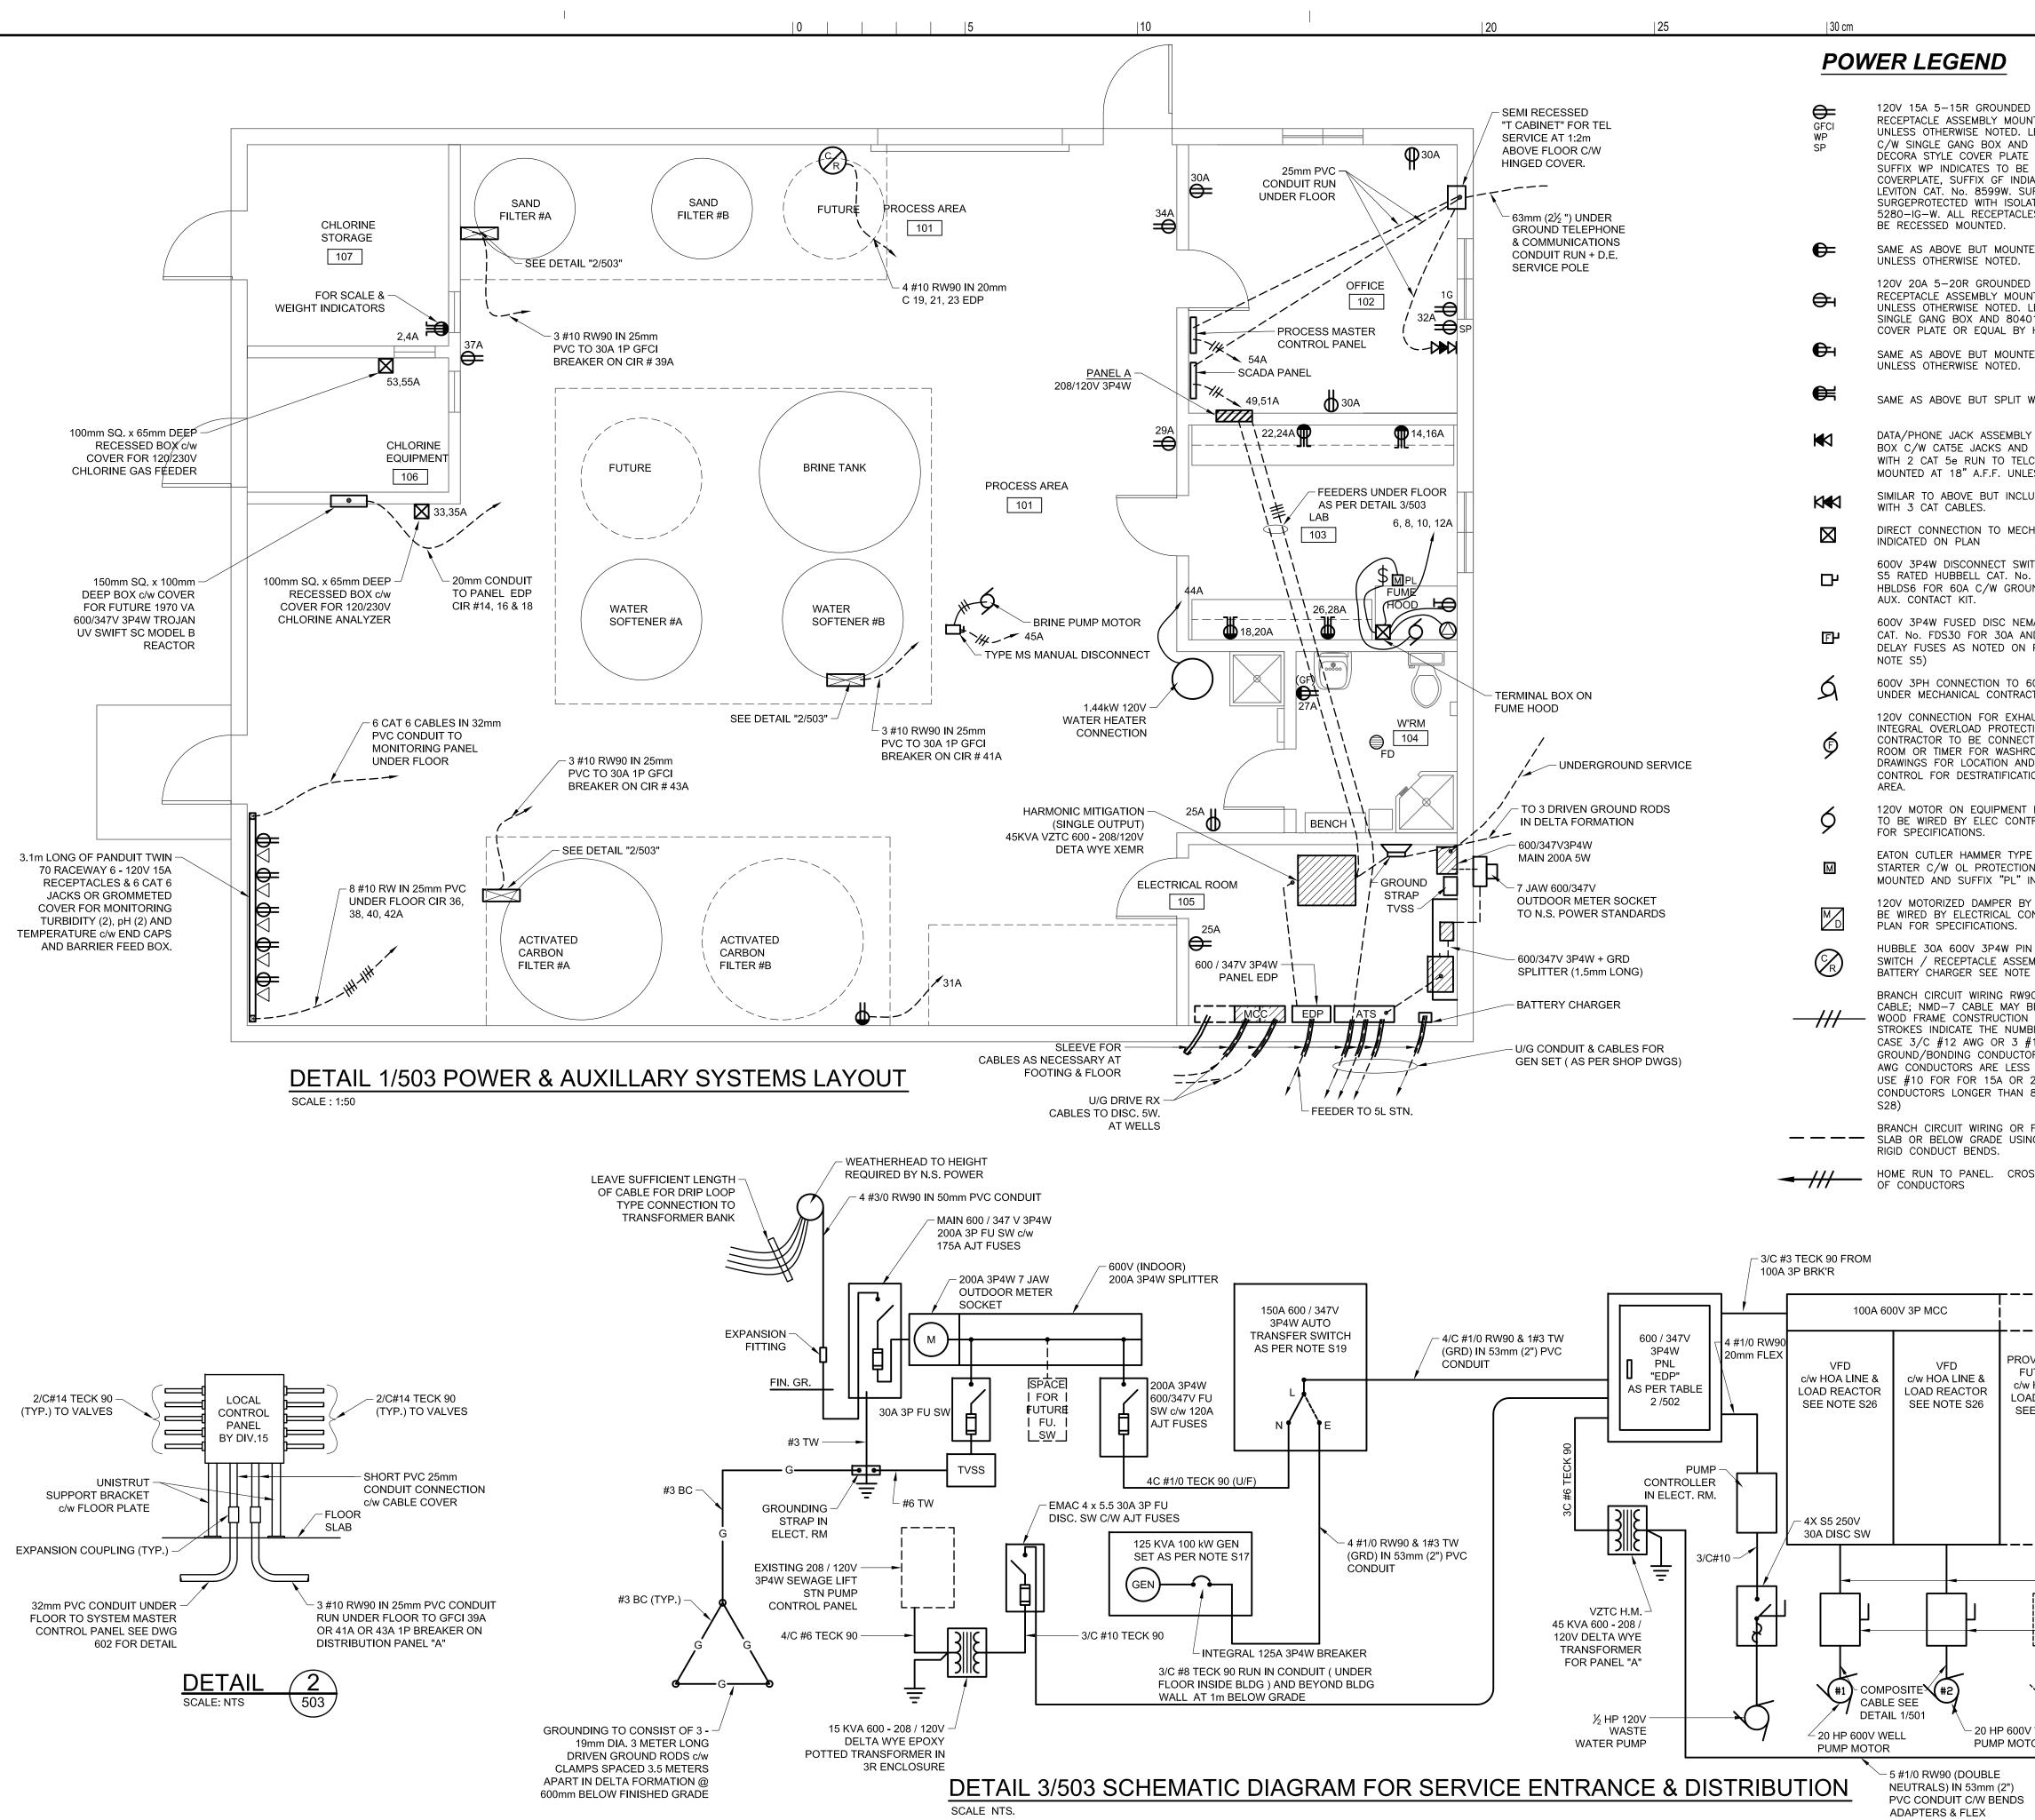

	No.	Issue		Date
D WHITE NYLON DECORA STYLE NTED 18" (457mm) A.F.F. LEVITON CAT. No. 16252W DEVITON 80401–W WHITE OR EQUAL BY HUBBELL, C/W WEATHERPROOF				
IATÉS TO BE GFCI PROTECTED UFFIX SP INDICATES TO BE ATED GROUND LEVITON CAT. No. ES IN FINISHED AREAS ARE TO "ED 42" (1066mm) A.F.F. D WHITE DECORA STYLE	1.	DTES: THIS DRAWING IS TO BE REA ALL OTHER DRAWINGS AND ELECTRICAL CONTRACTOR T CORD ASSEMBLY OR BATTER COMPATIBLE WITH HUBBELL	SPECIFICATIO O VERIFY THA RY CHARGER I	NS. \T PLUG / S
NTED 18" (457mm) A.F.F. LEVITON CAT. No. 16352W C.W 01–W WHITE DECORA STYLE HUBBELL TED 42" (1066mm) A.F.F.		RECEPTACLE TYPE.		
WIRED.				
Y 2 PORT HUBBELL H12CBSS H1C CONNECTOR COVERS .COM T CABINET. (TO BE ESS OTHERWISE NOTED).				
UDES JACK FOR FAX AND FED				
THANICAL EQUIPMENT AS				
MA TYPE 4X RATED HUBBELL				
ND FDS60 FOR 60A C/W TIME PLAN OR DETAIL. (SEE ALSO				
60V 3 PH MOTOR SUPPLIED CT.		I		
AUST FAN MOTOR WITH TION BY MECHANICAL CTED TO LIGHT SWITCH IN SAME ROOMS. SEE MECHANICAL ID SPECIFICATION FOR FAN TION FANS IN GARAGE/SHOP				
BY MECHANICAL CONTRACTOR, TRACTOR. SEE MECHANICAL PLAN	1 No.	Record Information Added Revision	GAR Ckd. By	Nov. 2011 Date
E MS 120V MANUAL MOTOR DN ("F" INDICATES FLUSH INDICATES C/W PILOT LIGHT. Y MECHANICAL CONTRACTOR, TO	Stamp		Const. North	3
ONTRACTOR. SEE MECHANICAL N & SLEVE CIRCUIT LOCK MBLY HBL 430 M15WR FOR				<b>Z</b>
E 2 90 IN EMT CONDUIT OR AC90 BE USED IF CONCEALED IN I FOR 250V MAX, CROSS BER OF CONDUCTORS. IN THIS #12 AWG PLUS		ORIGINAL DRAWING STAMPED ON 02 July 2010 BY	Drawn By:	STAFF
DR IN CONDUIT, ENSURE #12 S THAN 80', (FROM SOURCE) 20A CIRCUITS WITH 80'. (SEE ALSO NOTES S27 &		D. J. CAMERON P. ENG.	Dwg. Standard Ckd. By: Designed By:	S
FEEDER RUN UNDER FLOOR NG CORILINE PVC CONDUIT AND			Dwg. Design Ckd. By:	
DSS STROKES INDICATE QUANTITY	Date F	Printed 2-JULY-2010	Branch Manager:	
	]	HO ASSOCIA consulting a	ATES LI	MITED
225A 208 / 120V 3P-5W PANEL "A" AS PER TABLE 1/E502	89 Que Truro,	een Street NS		
UTURE VFD VHOA LINE & AD REACTOR	Client			
EE NOTE S26	1	Municipality of E	East Ha	ants
	Projec	t Title		
CONDUIT SLEEVE		Shubenad Water Treatm		int
IN CONDUIT SLEEVE		Electrical Po Auxiliary Syster & Detai	ns Lay	out
V WELL - FUTURE PUMP	Projec	LH09221		
,	Dwg. I	<sup>No.</sup> 503	Re	ev. No. 1
	Scale	AS NOTE		

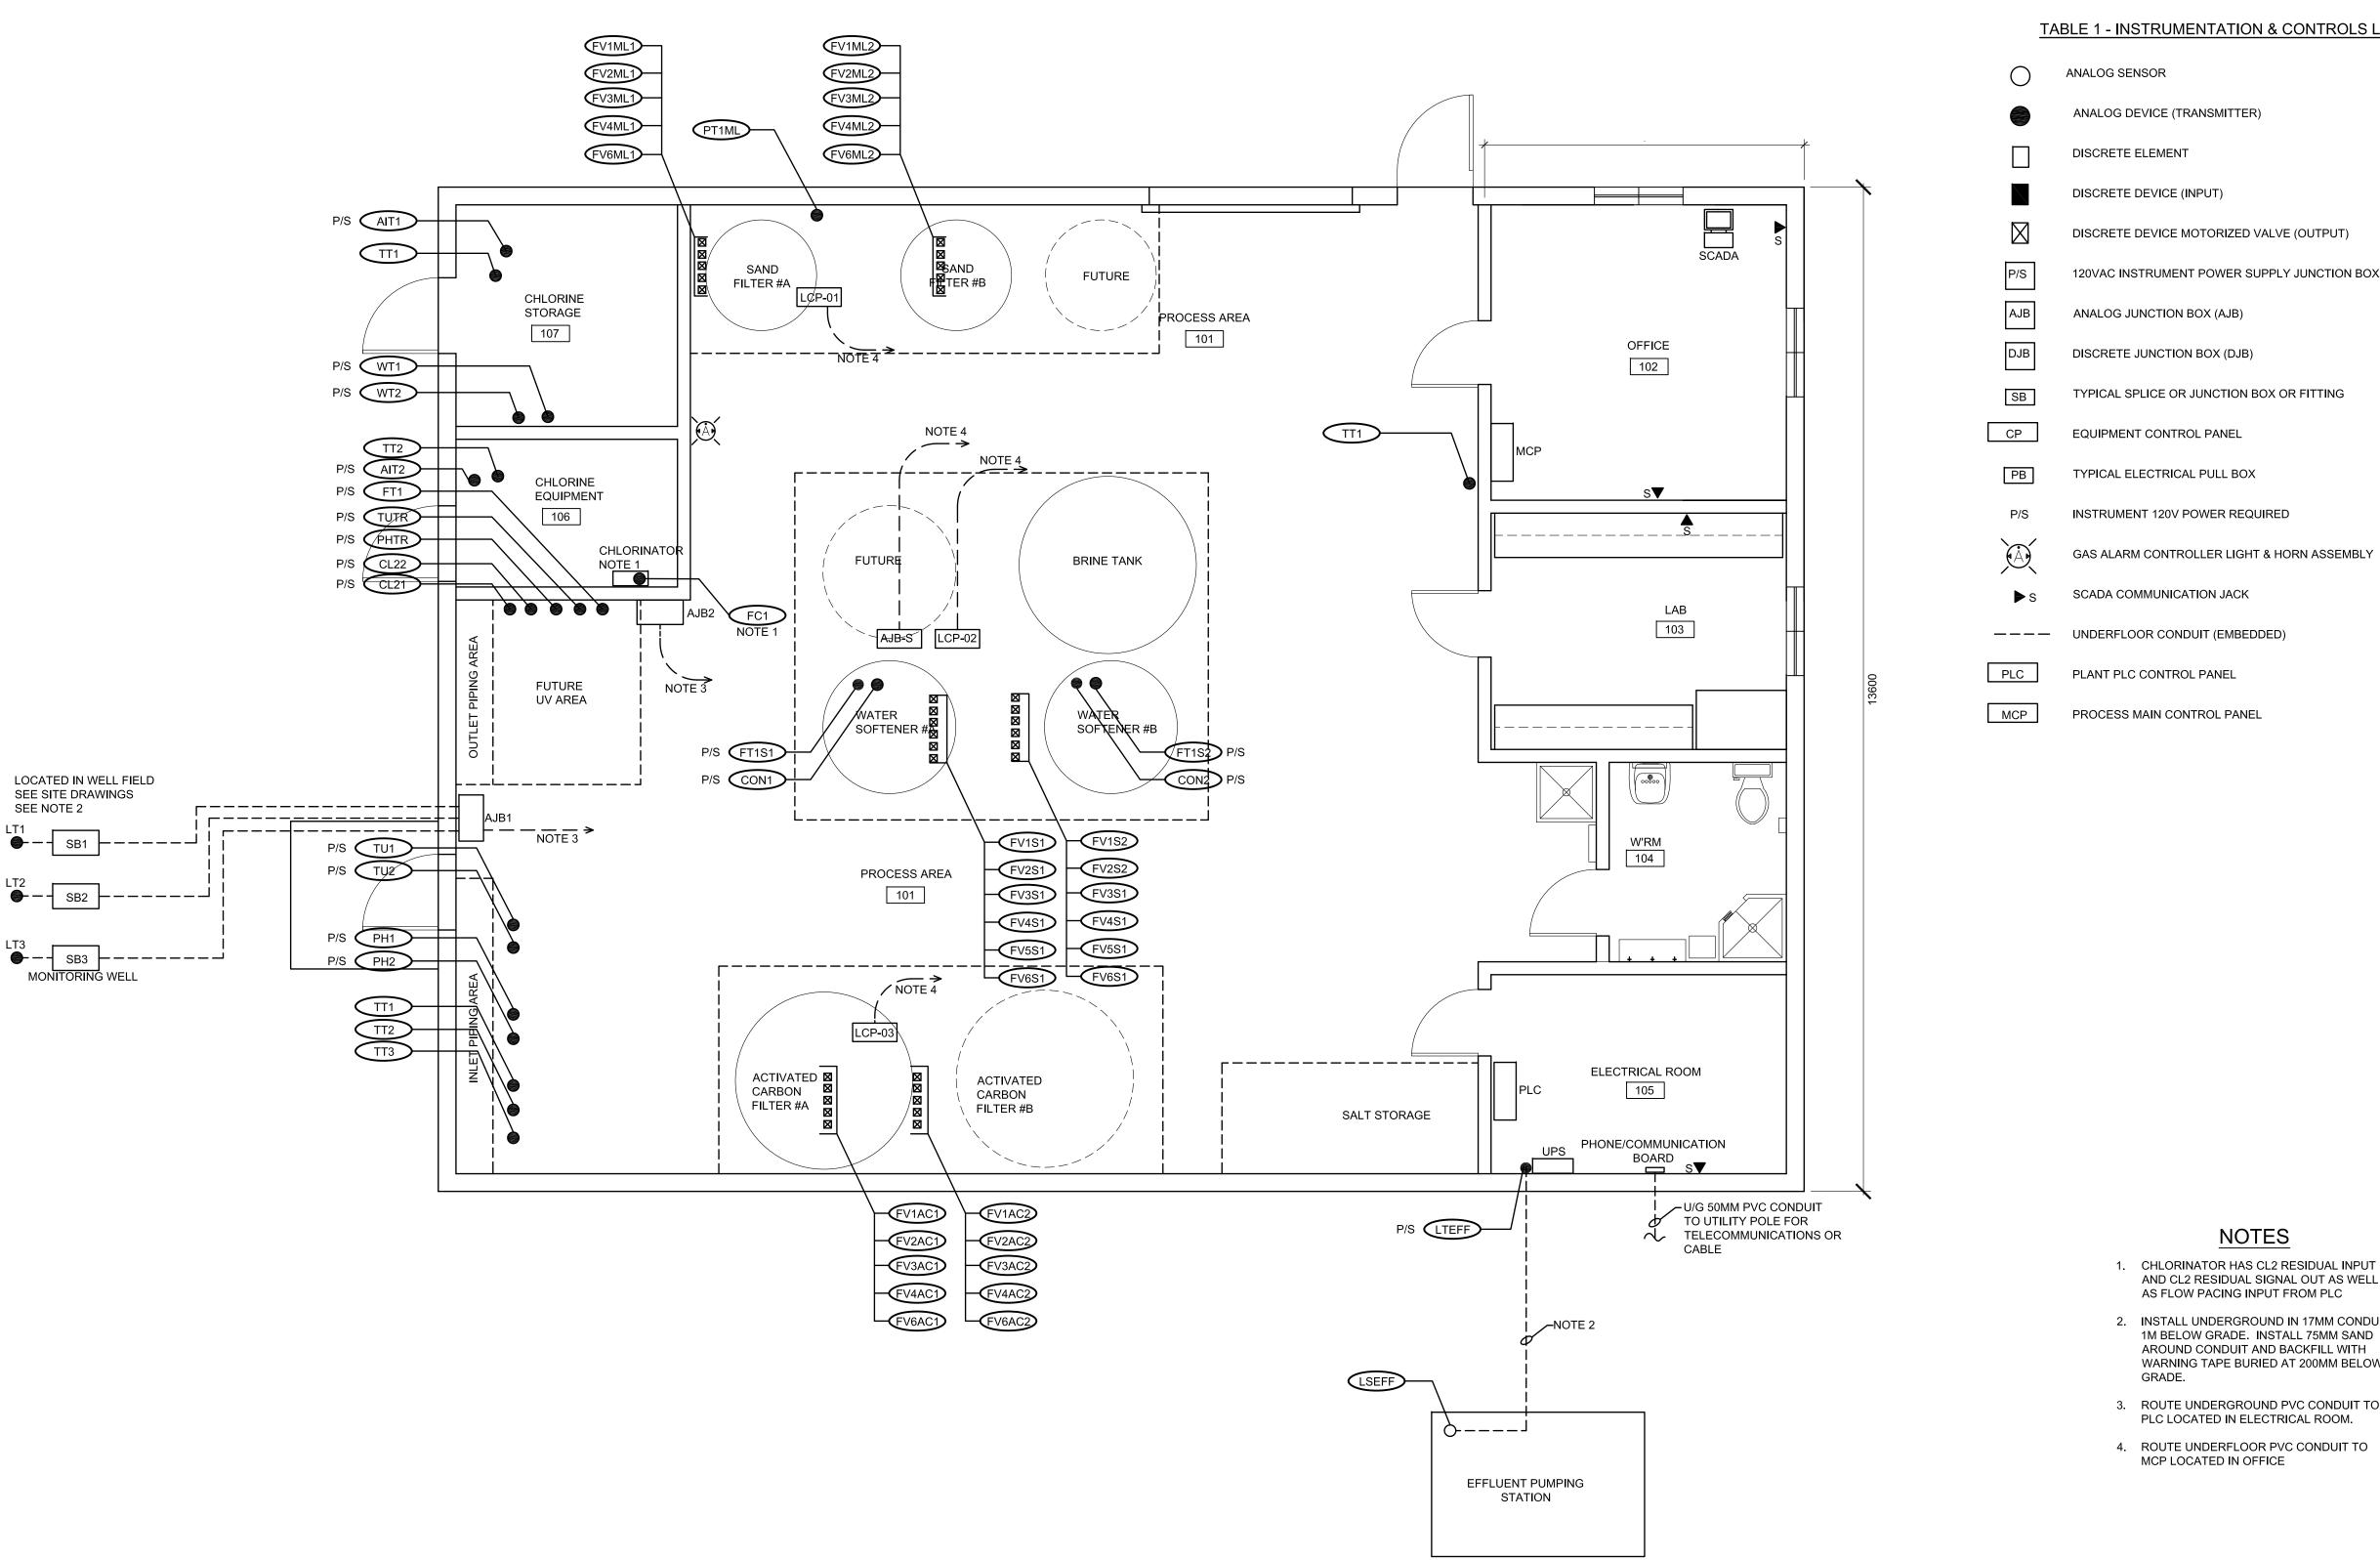

# BUILDING FLOOR PLAN

SCALE: 1:50

|10

20

25

| 30 cm

#### TABLE 1 - INSTRUMENTATION & CONTROLS LEGEND

120VAC INSTRUMENT POWER SUPPLY JUNCTION BOX (PSJB)

### NOTES

AND CL2 RESIDUAL SIGNAL OUT AS WELL AS FLOW PACING INPUT FROM PLC

2. INSTALL UNDERGROUND IN 17MM CONDUIT 1M BELOW GRADE. INSTALL 75MM SAND AROUND CONDUIT AND BACKFILL WITH WARNING TAPE BURIED AT 200MM BELOW

3. ROUTE UNDERGROUND PVC CONDUIT TO PLC LOCATED IN ELECTRICAL ROOM.

4. ROUTE UNDERFLOOR PVC CONDUIT TO


	Issue		Date
1			
	Record Information Added	GAR	Nov. 2011
1	Record Information Added Preliminary Review	GAR	Nov. 2011 02-July-2010

### RECORD DRAWING

Star	np	Const. North
	ORIGINAL DRAWING STAMPED ON	Drawn By: JW
	02 July 2010	Dwg. Standards Ckd. By:
	BY M. E. JENKINS P. ENG.	Designed By:
		Dwg. Design Ckd. By:
Date	Printed 2-JULY- 2010	Branch Manager:



<sub>Client</sub>	nicipality of East I	Hants
Project Title		
W	Shubenacadie ater Treatment F	Plant
Drawing Title		
	<b>Control Device</b>	
	Location Drawin	a
	Location Drawin	9
Project No.		
Floject No.	LH0922160	
Dwg. No.	601	Rev. No. 1
Scale	1 : 50	
	I _ OU This drawing is not to be scaled	

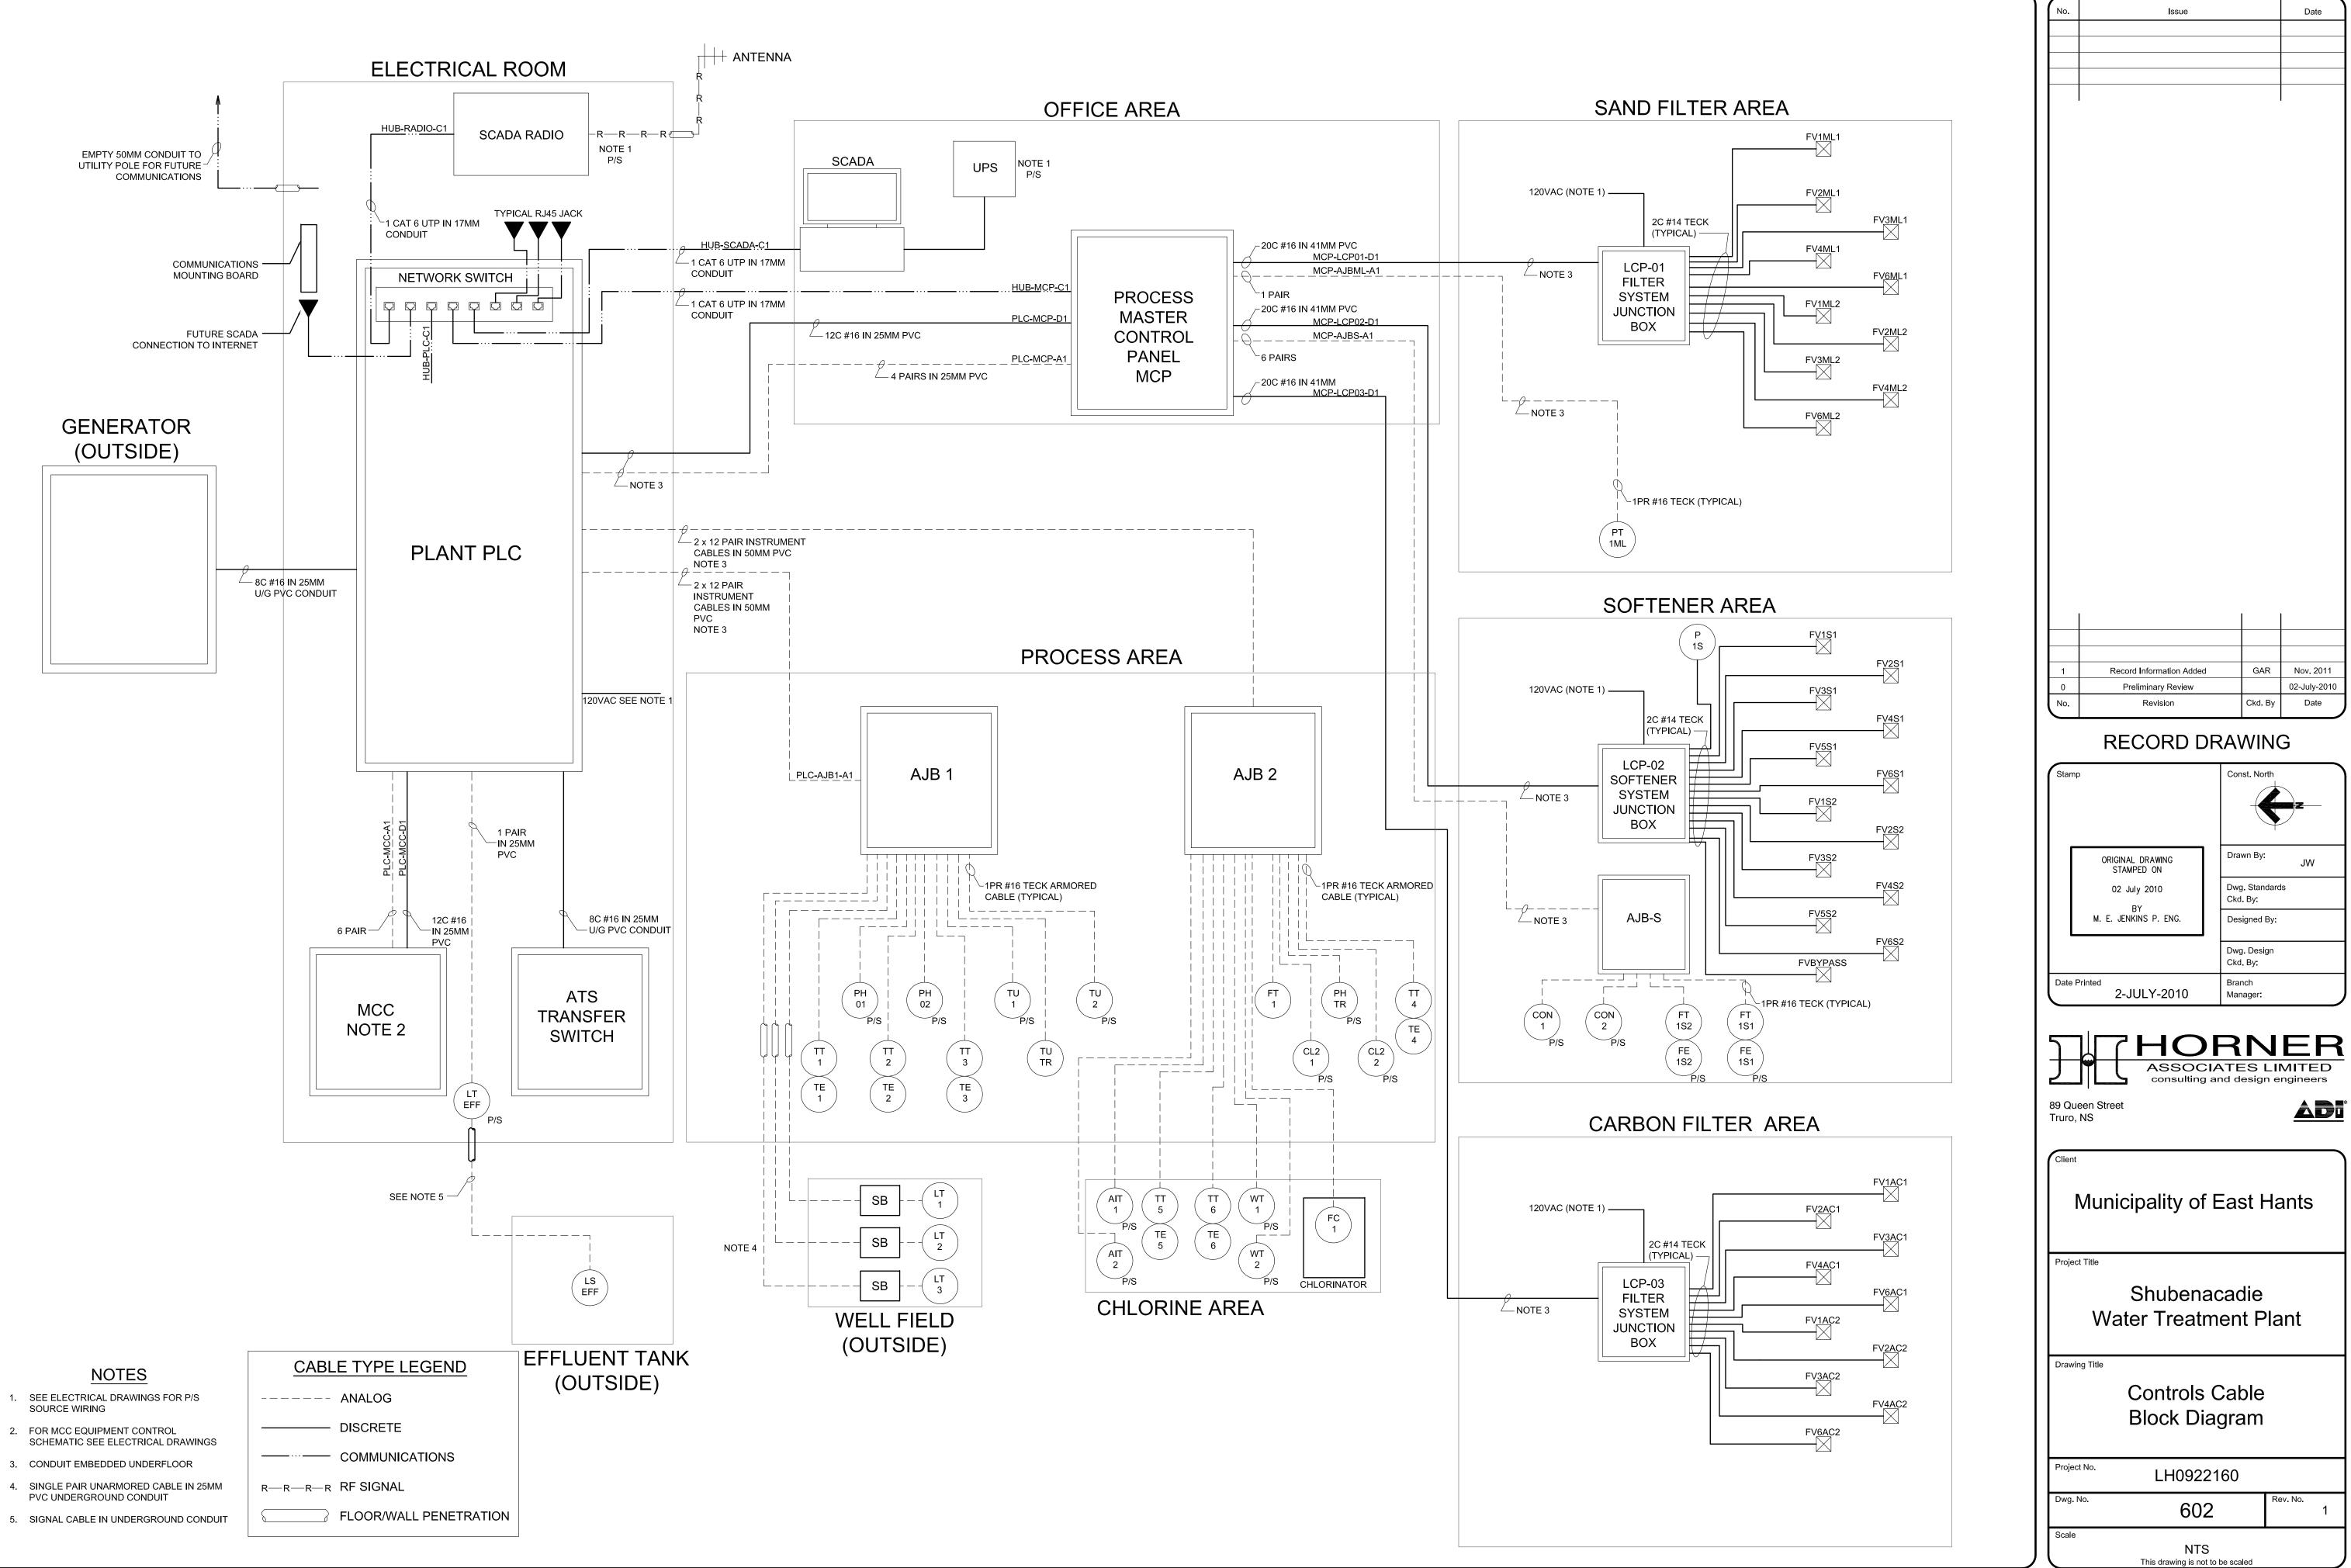

|10

20

25


\_\_\_\_\_

| 30 cm

Horner Associates Limited C 2007


|10



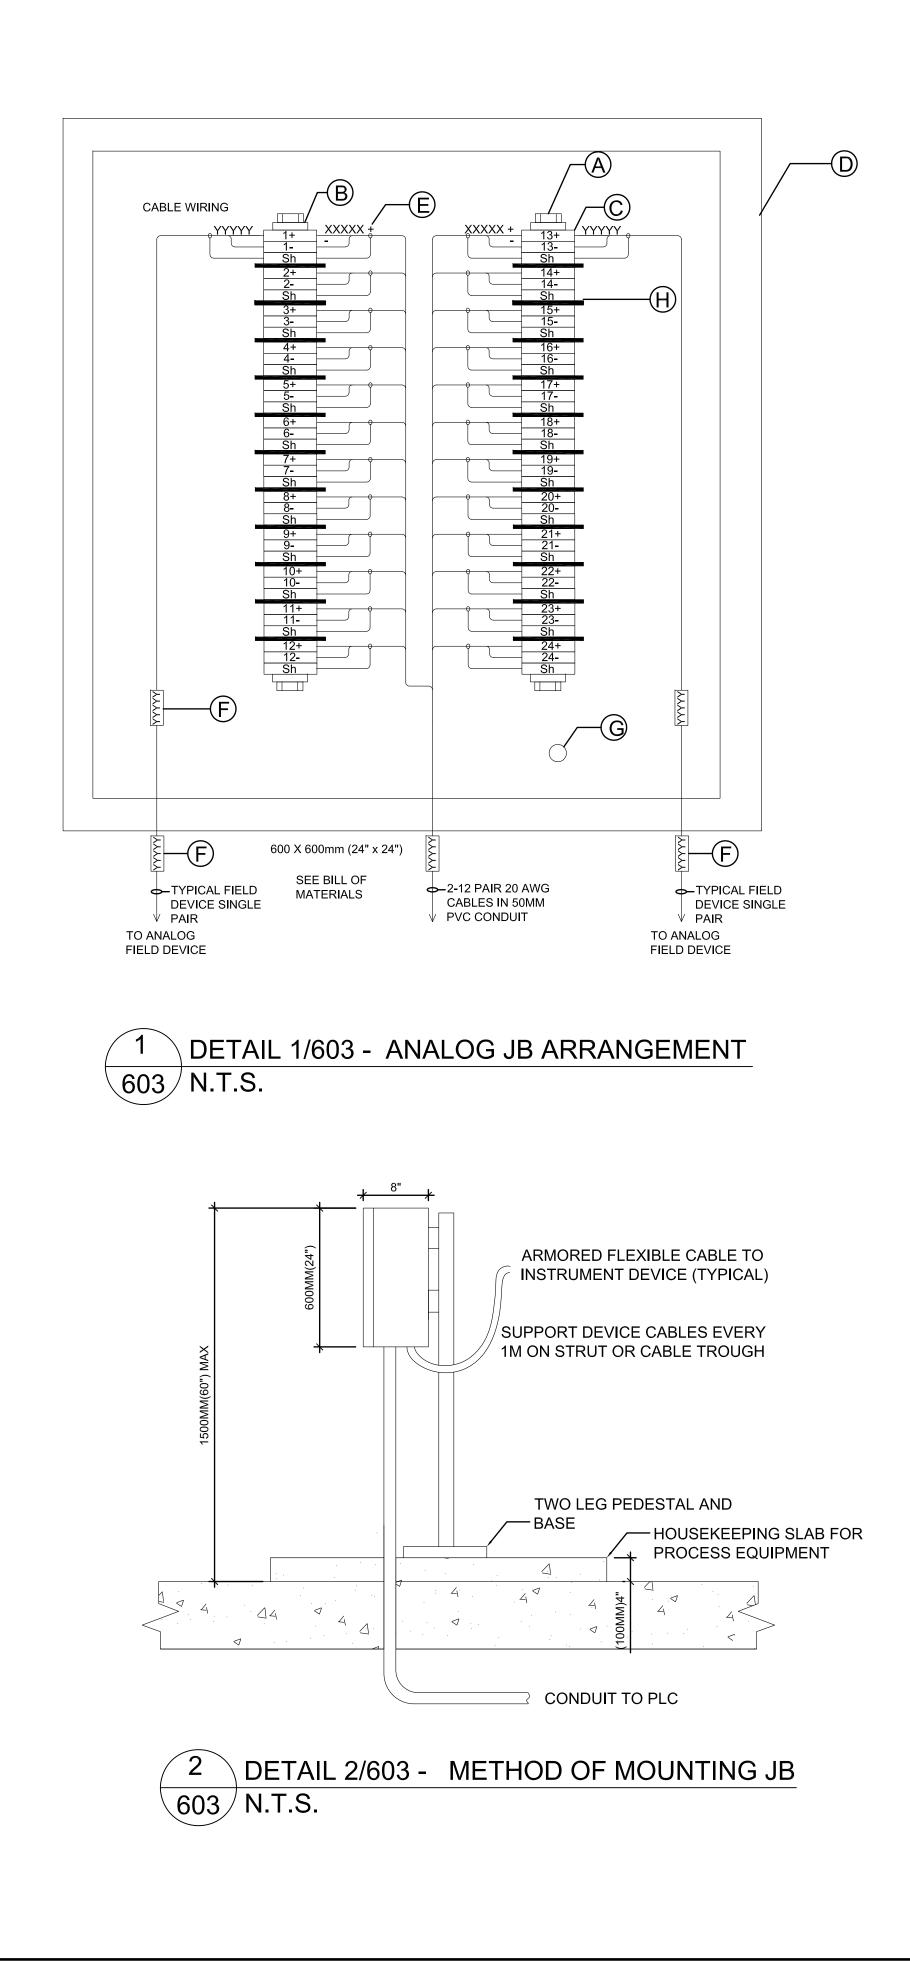

|--|

ITEM	DESCRIPTION	QTY/PANEL
A	DIN MOUNTING RAIL	1
B	TERMINAL BLOCK CLAMP	2
C	4mm FEED THROUGH TERMINAL	AS REQ
D	ENCLOSURE C/W BACKPLATE SIZE AS SHOWN	AS REQ
E	WIRE TAGS	AS REQ
F	CABLE TAGS	AS REQ
G	GROUND LUG	1
H	TYPICAL BARRIER & TERMINAL BLOCK	AS REQ

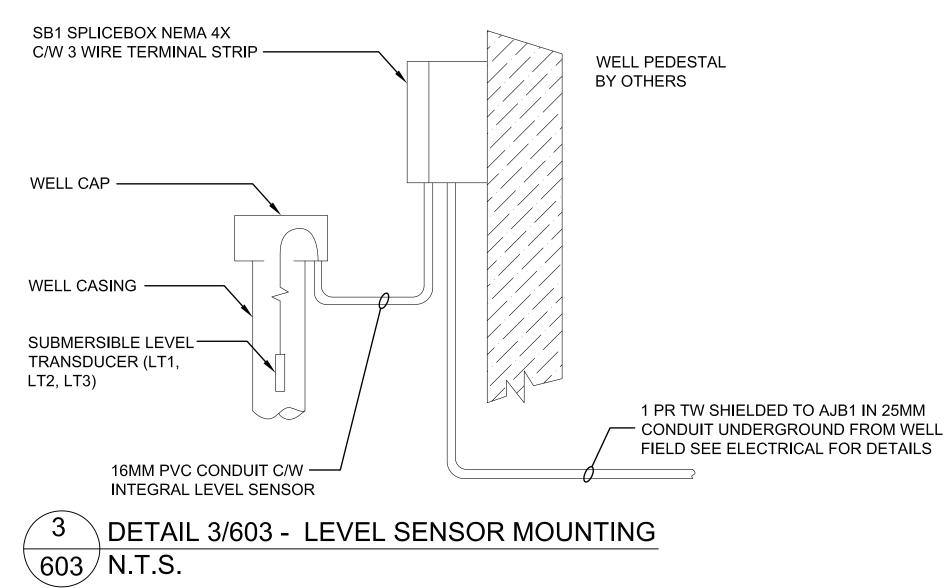

25

No.	Issue		Date
1	Record Information Added	GAR	Sept. 2011
0 No.	Preliminary Review Revision	Ckd. By	02-July-2010 Date
		RAWIN	G
Stam	p	Const. North	
			2
[	ORIGINAL DRAWING STAMPED ON	Drawn By:	JW
	02 July 2010 BY	Dwg. Standar Ckd. By:	ds
	M. E. JENKINS P. ENG.	Designed By:	
Date	Printed	Dwg. Design Ckd. By: Branch	
	2-SEPT-2010	Manager:	
7			
89 Qu Truro,	een Street NS		
Client			
	Municipality of	East H	ants
Projec			
	Shubena Water Treatm		ant
Duc		•	
Urawi	ng Title		
	[][	C	
	Detail	5	
Projec			

NTS This drawing is not to be scaled

**APPENDIX B** 

**Quotations from Suppliers** 



Certified to ISO9001:2015

10 Alden Road, Markham, ON, Canada L3R 2S1 (905) 475-1545 Fax: (905) 475-2021, E-Mail: info@napier-reid.com www.napier-reid.com

RV. Anderson 2001 Sheppard Ave. E Toronto ON M2J4Z8 Attn: Ian Lake-Thompson, M.A.Sc, P.Eng Date: Jan. 25<sup>th</sup>, 2023

File: PR-8922

#### BUDGETARY PROPOSAL

#### Re: Water Treatment Equipment, East Hants Shubenacadie WTP, NS

We are pleased to present this budgetary proposal for the supply of water treatment equipment consisting of sand filters, water softeners, activated carbon filter complete with instrumentation and controls for the above referenced wastewater treatment facility.

#### SCOPE OF SUPPLY (BY NAPIER-REID LTD.)

#### Sand Filters

TWO Sand pressure filters designed for a treated water peak flow rate of 200 USgpm per filter at a maximum pressure drop of 10 psi. Backwash water is 300 USgpm per filter using treated chlorinated water from the owner's distribution system.

Filter tankage and piping will be designed for a normal operating pressure of 105 psi and a maximum operating pressure of 150 psi, as specified.

Filter tankage will be 1520mm diameter by 1520mm sidewall height and constructed of carbon steel complete with top and bottom heads, four structural steel support legs and lifting lugs.

Each filter shall include the following components:

- 350 x 450mm man way on the top head.
- Lifting lugs provided in the top head.
- 25mm coupling on top head c/w air/vacuum release valve.
- 25mm coupling on bottom head c/w ball valve (vessel drain).
- 100mm flanged connections for inlet & outlet.
- 100mm influent distribution/backwash outlet header in 304SS construction.

- Underdrain system consisting of 100mm PVC Sch. 80 hub with 16 slotted PVC laterals.
- Filter media conforming/certified to NSF 61/AWWA standard is as follows:
  - 1360 kg of support gravel
  - 545 kg of 8 x 12 garnet
  - 730 kg of 30 x 40 garnet
  - 1365 kg of silica sand 0.45 to 0.55 mm
  - 0.68 m<sup>3</sup> of anthracite 0.9-1.0 mm
- Process control valves per filter including:

Four (4) 100mm diameter lug style butterfly valves c/w pre-mounted On/Off electric actuator (influent, effluent, rinse and backwash out) and one (1) 100mm diameter lug style butterfly valve c/w pre-mounted modulating electric actuator (backwash inlet).

- Manual valves per filter:

Three (3) 100mm diameter lug style manual butterfly valves (influent, effluent and backwash inlet).

Two (2) 100mm diameter check valves (influent and backwash inlet).

One (1) 50mm diameter manual ball valve (drain).

One (1) 25mm diameter manual ball valve (vessel drain).

Two (2) 6mm diameter ball valves for sample (influent and effluent).

Instruments and sensors per filter:

Differential pressure transmitter with display and 4-20 mA output for indication of head loss through the filters (common for two filters).

Pressure gauges, 0-160 psi on filter inlet and outlet line.

Local filter control junction box, NEMA1 rating.

ONE Common Face Piping for the two sand filters:

Face piping and fittings for each filter will be supplied in Sch. 10 316L stainless steel. The piping will be supplied in spool pieces for onsite installation by others.

#### Water Softeners

TWO Water softeners, designed for a treated water peak flow rate of 155 USgpm per softener at a maximum pressure drop across the softener of 15 psi. Backwash water shall be limited to 130 USgpm per softener using filtered water from the sand filters.

Softener tankage and piping will be designed for a normal operating pressure of 105 psi and a maximum operating pressure of 150 psi, as specified.

Softener tankage will be 1830mm diameter by 1830mm sidewall height and constructed of carbon steel complete with top and bottom heads, four structural steel support legs and lifting lugs.

Each water softener will include the following components:

- 350 x 450mm manway on the top head.
- Lifting lugs provided in the top head.
- 25mm coupling on top head c/w air/vacuum release valve.
- 38mm coupling on bottom head c/w ball valve (vessel drain).
- 100mm flanged connections for inlet & outlet.
- 100mm influent distribution/backwash outlet header in SS 304 construction.
- Under drain system consisting of 100 mm PVC Sch. 80 hub with 16 slotted PVC laterals.
- Softener media consists of the following specified materials:
  - 1590 kg of support gravel
  - 2.83 m<sup>3</sup> of cation exchange resin, 8% cross-link
- Process control valves per softener:

Two (2) 100mm diameter lug style butterfly valves c/w pre-mounted On/Off electric actuator (influent and effluent).

Two (2) 75mm diameter lug style butterfly valves c/w pre-mounted On/Off electric actuator (rinse/brine outlet and backwash out).

One (1) 75mm diameter lug style butterfly valve c/w pre-mounted modulating electric actuator (backwash in).

One (1) 50mm diameter lug style butterfly valve c/w pre-mounted On/Off electric actuator (brine inlet).

Manual valves per softener:

Two (2) 100mm diameter lug style manual butterfly valves (influent and effluent).

One (1) 100mm check valve (influent).

One (1) 50mm diameter lug style manual butterfly valve (brine inlet).

One (1) 50mm diameter manual ball valve (drain).

One (1) 38mm diameter manual ball valve (vessel drain).

Two (2) 6mm diameter ball valves for sample (influent and effluent).

- Instruments and sensors per softener:

Differential pressure transmitter with display and 4-20 mA output for indication of head loss through the softeners (common for two softeners).

4" ABB magnetic flow meter (at inlet of each softener).

Pressure gauges, 0-150 psi on softener inlet and outlet line.

Local softener control junction box, NEMA1 rating.

ONE Common Face Piping for the two water softeners:

Face piping for each softener will be supplied in Sch. 10 316L stainless steel. The piping will be supplied in spool pieces for onsite installation, by others.

- ONE Brine regeneration system consists of:
  - Polyethylene brine solution tank 2438mm (96") dia.x1956mm (77") H
  - Two float level switches
  - Centrifugal brine pump c/w 575/3/60 motor
  - Feed water control valve
  - 1.5" ABB magnetic flow meter for Brine solution
  - Specified piping and isolation valves

#### Activated Carbon Filter

ONE Activated carbon filter designed for a treated water peak flow rate of 200 USgpm at a maximum pressure drop of 10 psi. Backwash water shall be limited to 500 USgpm using treated chlorinated water from Owner's distribution system.

Filter tankage and piping will be designed for a normal operating pressure of 105 psi and a maximum operating pressure of 150 psi, as specified.

Filter tankage will be 2440mm diameter by 1520mm sidewall height and constructed of carbon steel complete with top and bottom heads, four structural steel support legs and lifting lugs.

The filter will include the following components:

- 350 x 450mm man way on the top head.
- Lifting lugs provided in the top head.
- 25mm coupling on top head c/w air/vacuum release valve.
- 38mm coupling on bottom head c/w ball valve (vessel drain).
- 100mm flanged connections for inlet and outlet.
- 100mm influent distribution/backwash outlet header in 304SS construction.
- Under drain system consisting of 100mm 304SS header with 18 slotted PVC laterals.
- Filter media conforming/certified to NSF 61/AWWA standard consisting of:
  - 4090 kg of No.20 washed and graded gravel sub-fill;
  - 5.6 m<sup>3</sup> of HAC 12 x 40 or equal, granular activated carbon
- Process control valves:

Four (4) 100mm diameter lug style butterfly valves c/w pre-mounted On/Off electric actuator (influent, effluent, rinse and backwash out) and one (1) 100mm diameter lug style butterfly valve c/w pre-mounted Modulating electric actuator (backwash in).

Manual valves:

Three (3) 100mm diameter lug style manual butterfly valves (influent, effluent and backwash inlet).

Two (2) 100mm diameter check valves (influent and backwash inlet).

One (1) 50mm diameter manual ball valve (drain).

One (1) 38mm diameter manual ball valve (drain).

Two (2) 6mm diameter ball valves for sample (influent and effluent).

Instruments and sensors:

Differential pressure transmitter with display and 4-20 mA output for indication of head loss through the filter.

Pressure gauges, 0-150 psi for filter inlet and outlet line.

Local filter control junction box, NEMA1 rating.

ONE Set of common face piping:

Face piping for each filter will be supplied in Sch. 10 316L stainless steel. The piping will be supplied in spool pieces for onsite installation, by others.

#### Master Treatment System Control

PLC based master control panel designed to control operation of the sand filters, softeners and carbon filter. Control panel will monitor the flow rate and water usage through the treatment equipment, and will schedule and control the backwashing of the equipment based on the backwash program for each component.

Master treatment system control shall consist of the following:

ONE EEMAC 4, 120/1/60 PLC Control panel complete with:

- Main disconnect
- Primary and secondary fusing
- Control relays complete with bases
- Allen-Bradley CompactLogix processor with digital input and output cards analog input and output card, battery and power supply
- Wiring terminals
- Pilot lights
- PanelView Plus touch-screen operator interface

Wiring to and from the panel is supplied and installed by others.

#### Shop Drawings

4 Sets of shop drawings

**Operation & Maintenance Manuals** 

4 Sets of O & M manuals in English

#### Field Service and Inspection

Napier-Reid will provide site services as follows:

- One (1) day: Installation instruction for the systems
- Three (3) days: Mechanical equipment inspection
- Five (5) days: Start-up and commissioning
- One (1) day: Inspection, adjustment & calibration, 6 months after start-up
- One (1) day: Inspection, adjustment & calibration, 12 months after start-up

Additional site visits can be provided based on following rate:

- Weekdays: CAD\$1,280 per man.day (up to 8man.hours/day)
- Overtime, weekends & holidays: CAD\$200 per man.hour (up to 10man.hours/day)
- Travel time: CAD\$150 per man.hour (up to \$1,280/man.day)

Expenses will be extra and billed at cost plus 10%. All Napier Reid site personnel are non-union.

#### <u>Warranty</u>

Napier-Reid Ltd. warrants all equipment manufactured or supplied by it to be free from defects in design, workmanship and material, and conforming to the specification for a period of 12 months from the day of successful start-up or 18 months after shipment, whichever occurs first.

#### TOTAL LOT BUDGETARY PRICE For the Equipment Above......CAD\$1,130,000.00

#### **OPTION: ADDING ITEMS TO MATCH THE EXISTING**

#### Sand Filter

ONE Sand pressure filter (same as the existing sand filter) designed for a treated water peak flow rate of 200 USgpm at a maximum pressure drop of 10 psi. Backwash water is 300 USgpm using treated chlorinated water from the owner's distribution system.

Filter tankage and piping will be designed for a normal operating pressure of 105 psi and a maximum operating pressure of 150 psi, as specified.

Filter tankage will be 1520mm diameter by 1520mm sidewall height and constructed of carbon steel complete with top and bottom heads, four structural steel support legs and lifting lugs.

The filter shall include the following components:

- 350 x 450mm man way on the top head.
- Lifting lugs provided in the top head.
- 25mm coupling on top head c/w air/vacuum release valve.
- 25mm coupling on bottom head c/w ball valve (vessel drain).
- 100mm flanged connections for inlet & outlet.
- 100mm influent distribution/backwash outlet header in 304SS construction.
- Underdrain system consisting of 100mm PVC Sch. 80 hub with 16 slotted PVC laterals.
- Filter media conforming/certified to NSF 61/AWWA standard is as follows:
  - 1360 kg of support gravel
  - 545 kg of 8 x 12 garnet
  - 730 kg of 30 x 40 garnet
  - 1365 kg of silica sand 0.45 to 0.55 mm
  - 0.68 m<sup>3</sup> of anthracite 0.9-1.0 mm
- Process control valves, including:

Four (4) 100mm diameter lug style butterfly valves c/w pre-mounted On/Off electric actuator (influent, effluent, rinse and backwash out) and one (1) 100mm diameter lug style butterfly valve c/w pre-mounted modulating electric actuator (backwash inlet).

- Manual valves:

Three (3) 100mm diameter lug style manual butterfly valves (influent, effluent and backwash inlet).

Two (2) 100mm diameter check valves (influent and backwash inlet).

One (1) 50mm diameter manual ball valve (drain).

One (1) 25mm diameter manual ball valve (vessel drain).

Two (2) 6mm diameter ball valves for sample (influent and effluent).

Instruments and sensors:

Differential pressure transmitter with display and 4-20 mA output for indication of head loss through the filters (common for two filters).

Pressure gauges, 0-160 psi on filter inlet and outlet line.

Local filter control junction box, NEMA1 rating.

Face Piping:

Face piping and fittings for the filter will be designed to match the existing filters and supplied in Sch. 10 316L stainless steel. The piping will be supplied in spool pieces for onsite installation by others.

#### Water Softener

ONE Water softener (same as the existing softener) designed for a treated water peak flow rate of 155 USgpm at a maximum pressure drop across the softener of 15 psi. Backwash water shall be limited to 130 USgpm using filtered water from the sand filters.

Softener tankage and piping will be designed for a normal operating pressure of 105 psi and a maximum operating pressure of 150 psi, as specified.

Softener tankage will be 1830mm diameter by 1830mm sidewall height and constructed of carbon steel complete with top and bottom heads, four structural steel support legs and lifting lugs.

The water softener will include the following components:

- 350 x 450mm manway on the top head.
- Lifting lugs provided in the top head.
- 25mm coupling on top head c/w air/vacuum release valve.
- 38mm coupling on bottom head c/w ball valve (vessel drain).
- 100mm flanged connections for inlet & outlet.
- 100mm influent distribution/backwash outlet header in SS 304 construction.
- Under drain system consisting of 100 mm PVC Sch. 80 hub with 16 slotted PVC laterals.
- Softener media consists of the following specified materials:

- 1590 kg of support gravel
- 2.83 m<sup>3</sup> of cation exchange resin, 8% cross-link

Process control valves:

Two (2) 100mm diameter lug style butterfly valves c/w pre-mounted On/Off electric actuator (influent and effluent).

Two (2) 75mm diameter lug style butterfly valves c/w pre-mounted On/Off electric actuator (rinse/brine outlet and backwash out).

One (1) 75mm diameter lug style butterfly valve c/w pre-mounted modulating electric actuator (backwash in).

One (1) 50mm diameter lug style butterfly valve c/w pre-mounted On/Off electric actuator (brine inlet).

- Manual valves:

Two (2) 100mm diameter lug style manual butterfly valves (influent and effluent).

One (1) 100mm check valve (influent).

One (1) 50mm diameter lug style manual butterfly valve (brine inlet).

One (1) 50mm diameter manual ball valve (drain).

One (1) 38mm diameter manual ball valve (vessel drain).

Two (2) 6mm diameter ball valves for sample (influent and effluent).

Instruments and sensors:

Differential pressure transmitter with display and 4-20 mA output for indication of head loss through the softeners (common for two softeners).

4" ABB magnetic flow meter (at inlet of each softener).

Pressure gauges, 0-150 psi on softener inlet and outlet line.

Local softener control junction box, NEMA1 rating.

- Face Piping:

Face piping for the softener will be designed to match the existing softeners and supplied in Sch. 10 316L stainless steel. The piping will be supplied in spool pieces for onsite installation, by others.

- Brine regeneration system consists of:
  - Polyethylene brine solution tank 2438mm (96") dia.x1956mm (77") H
  - Two float level switches
  - Centrifugal brine pump c/w 575/3/60 motor
  - Feed water control valve
  - 1.5" ABB magnetic flow meter for Brine solution
  - Specified piping and isolation valves

#### Activated Carbon Filter

ONE Activated carbon filter (same as the existing GAC filter) designed for a treated water peak flow rate of 200 USgpm at a maximum pressure drop of 10 psi. Backwash water shall be limited to 500 USgpm using treated chlorinated water from Owner's distribution system.

Filter tankage and piping will be designed for a normal operating pressure of 105 psi and a maximum operating pressure of 150 psi, as specified.

Filter tankage will be 2440mm diameter by 1520mm sidewall height and constructed of carbon steel complete with top and bottom heads, four structural steel support legs and lifting lugs.

The filter will include the following components:

- 350 x 450mm man way on the top head.
- Lifting lugs provided in the top head.
- 25mm coupling on top head c/w air/vacuum release valve.
- 38mm coupling on bottom head c/w ball valve (vessel drain).
- 100mm flanged connections for inlet and outlet.
- 100mm influent distribution/backwash outlet header in 304SS construction.
- Under drain system consisting of 100mm 304SS header with 18 slotted PVC laterals.
- Filter media conforming/certified to NSF 61/AWWA standard consisting of:
  - 4090 kg of No.20 washed and graded gravel sub-fill;
  - 5.6 m<sup>3</sup> of HAC 12 x 40 or equal, granular activated carbon

- Process control valves:

Four (4) 100mm diameter lug style butterfly valves c/w pre-mounted On/Off electric actuator (influent, effluent, rinse and backwash out) and one (1) 100mm diameter lug style butterfly valve c/w pre-mounted Modulating electric actuator (backwash in).

- Manual valves:

Three (3) 100mm diameter lug style manual butterfly valves (influent, effluent and backwash inlet).

Two (2) 100mm diameter check valves (influent and backwash inlet).

One (1) 50mm diameter manual ball valve (drain).

One (1) 38mm diameter manual ball valve (drain).

Two (2) 6mm diameter ball valves for sample (influent and effluent).

Instruments and sensors:

Differential pressure transmitter with display and 4-20 mA output for indication of head loss through the filter.

Pressure gauges, 0-150 psi for filter inlet and outlet line.

Local filter control junction box, NEMA1 rating.

Face Piping:

Face piping for the filter will be designed to match the existing GAC filter and supplied in Sch. 10 316L stainless steel. The piping will be supplied in spool pieces for onsite installation, by others.

#### Master Treatment System Control

PLC based master control panel (same as the existing panel) designed to control operation of the sand filters, softeners and carbon filter. Control panel will monitor the flow rate and water usage through the treatment equipment, and will schedule and control the backwashing of the equipment based on the backwash program for each component.

Master treatment system control shall consist of the following:

ONE EEMAC 4, 120/1/60 PLC Control panel complete with:

- Main disconnect
- Primary and secondary fusing
- Control relays complete with bases
- Allen-Bradley CompactLogix processor with digital input and output cards analog input and output card, battery and power supply
- Wiring terminals
- Pilot lights
- PanelView Plus touch-screen operator interface

Wiring to and from the panel is supplied and installed by others.

#### TOTAL LOT BUDGETARY PRICE For the Optional Items......CAD\$870,000.00

#### <u>Terms:</u>

- Ex-Work, Napier-Reid shops, Markham, ON, Canada
- Any Tax and duty excluded, if applicable
- Terms: Net 30 days after receipt of invoices.
- Payment schedule:
- 10% upon the receipt of shop drawings by the buyer's representative
- 25% upon the arrival of major materials at our shop for filter tank fabrication
- 20% upon the completion of the filter tank fabrication prior to sandblasting and coating
- 30% when equipment is ready for shipping
- 10% upon the arrival of the equipment on site, in good conditions
- 5% upon successful completion of Acceptance Test based on the electrical/mechanical performance of Napier-Reid supplied equipment
- Delivery: 22 to 26 weeks from approved drawings
- Drawings: 4 to 6 weeks from approved purchase order
- Price valid for 30 days.
- Napier-Reid Ltd. reserves its right to withhold equipment and/or services when payment is not received as per our terms, without penalty, not withstanding the terms and conditions in the purchaser' purchase order, tender specifications, or any other documents.
- In the event the purchase order is cancelled, Napier-Reid Ltd. reserves the right to receive reimbursement from the purchaser for all costs incurred up to the date of cancellation including design, manufacturing, fabrication, shipping, restocking charges and a prorated portion of profits.

NAPIER-REID LTD.

Hale

Peggy Pan, P.Eng., PMP Project Manager

Note:

- 1. The stainless-steel face piping and fittings (shop fabricated to maximum possible extent), valves and instrumentation will be shipped loose for installation by others.
- 2. Filter and softener media will be delivered to site in 0.5 or 1.0 cubic foot bags for installation by others.
- 3. Butterfly valves will be supplied in accordance with ANSI/AWWA Standard C-504 as manufactured by Pratt, Bray or Keystone.
- 4. The backwash inlet valves for the sand filters, softeners and activated carbon filter will be equipped with upsized actuators to ensure its smooth operation under the high line pressure from the supply side.
- 5. Sand filter, softener and activated carbon filter tankage interior will be primed and epoxy coated suitable for potable water applications. Exterior of tankage will be primed and epoxy coated.
- 6. Pressure vessels shall be designed, fabricated and tested as per ASME Sec. VIII, Div 1 and provided with appropriate code stamp.
- 7. Motor starter for brine pump will be provided in plant MCC by others.

#### Exclusions

Napier-Reid Ltd. excludes from its scope of supply the following items:

- Equipment shipping, unloading and storage at the jobsite.
- Field installation.
- Interconnecting piping including instrument air piping.
- Field wiring and conduits, field wire ways.
- Power, water, chemicals and labor for operating the equipment.
- Any field and laboratory testing.
- Field painting if required.
- Any equipment or services not specifically listed in this proposal.